

Marion
K 2021
7-30-77

MISSISSIPPI
BOARD OF WATER COMMISSIONERS
416 North State Street
Jackson, Mississippi 39201

134

WATER WELL DRILLERS LOG

7/30/77 19 77 Hollinger Well Marion
date well completed firm name county well located

LANDOWNER:	description of formations encountered	from	to
Vertis Woodson			
RT 3 Box 282			
Foxworth Miss.	GRAVEL, chert	0	80
(mailing address)	SAND, gravel	80	140

WELL LOCATION: 13
sec. 19 T 30 N R 28 E S
2 miles W of Foxworth
(distance) (direction) (nearest town)

WELL PURPOSE: Home
(home, irrigation, municipal, industrial)

WELL COMPLETION DATA:

(1) diameter (inches) 2"
(2) total depth (feet) 140
(3) static water level (feet) 80 below above top of ground.
(4) casing pvc 130 (material) (depth)
(size) If telescope see back.
(5) screen 10 130 (length) (depth to top)
(size) pvc (material)
(6) pump 1 1/2 9 (HP) (yield gpm)
elect (type power)
(7) electric log (yes or no)
(organization running log)

(8) how well bottom plugged SAND SHARK


DRILLERS REMARKS: good well

RECEIVED

SEP 19 1977

If well telescopes please sketch and show depths.

GROUND LEVEL

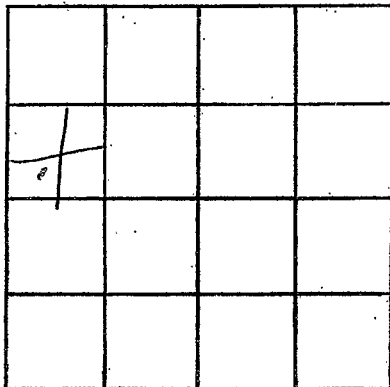

SECTION 19

Please indicate well location X.

ADDITIONAL INFORMATION

If more than one screen,
show locations of each on sketch.