

MARION
K 2022
6/17/77

MISSISSIPPI
BOARD OF WATER COMMISSIONERS
416 North State Street
13V Jackson, Mississippi 39201

WATER WELL DRILLERS LOG

6/17 1977 Hollinger Marion
date well completed firm name county well located

LANDOWNER: Thomas Camp
RT 1 Box 258
(mailing address)

description of formations encountered	from	to
CLAY, SAND	0	40
SAND, GRAVEL	40	60
SANDY	60	127

WELL LOCATION:
sec. 7 T 3 N R 17 E
S W
5 miles W of Foxworth
(distance) (direction) (nearest town)

WELL PURPOSE: Home
(home, irrigation, municipal, industrial)

WELL COMPLETION DATA:

(1) diameter (inches) 2"
(2) total depth (feet) 127
(3) static water level (feet) 80 below top of ground.
(4) casing PVC, 122 (material) (depth)
(size) if telescope see back.
(5) screen 5, 122 (length) (depth to top)
2" PVC (size) (material)
(6) pump 1 (HP) 7 (yield gpm)
elect (type power)
(7) electric log (yes or no)
(organization running log)

(8) how well bottom plugged sand SHOCK

DRILLERS REMARKS: good well


RECEIVED

JUL 11 1977

MISS. BD. OF WATER COMM

If well telescopes please sketch and show depths.

GROUND LEVEL

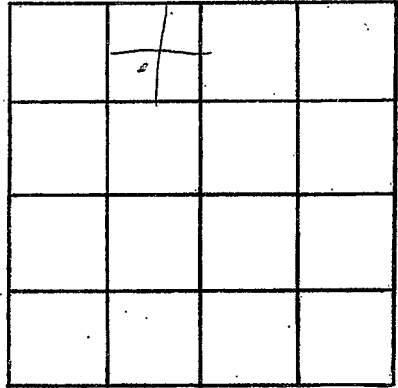

SECTION 7

Please indicate well location X.

ADDITIONAL INFORMATION

If more than one screen, show locations of each on sketch.