

MARION
 K 204
 10-13-78

MISSISSIPPI
 BOARD OF WATER COMMISSIONERS
 416 North State Street
 Jackson, Mississippi 39201

WATER WELL DRILLERS LOG

10/13 1978 Hollinger Well Service Marion
 date well completed firm name county well located

LANDOWNER: Hayward Crawford
 Rt 3 Box 296
 Foxworth, MS.
 (mailing address)

description of formations encountered	from	to
CLAY	0	20
gravel, CLAY	20	40
CLAY	40	50
PER GRAVEL	50	85

WELL LOCATION:
 sec. 20 T 3 N R 19 E
 13E
 1 miles W of Foxworth
 (distance) (direction) (nearest town)

WELL PURPOSE:
 (home, irrigation, municipal, industrial)

- WELL COMPLETION DATA:
- (1) diameter (inches) 2"
 - (2) total depth (feet) 85
 - (3) static water level (feet) 50 (below above top of ground)
 - (4) casing PVC (material) (depth) (size) if telescope see back.
 - (5) screen 10 75 (length) (depth to top)
 2" PVC (size) (material)
 - (6) pump 1 9 (HP) (yield gpm)
 elect (type power)
 - (7) electric log (yes or no)

(organization running log)
 (8) how well bottom plugged sand SHARK


DRILLERS REMARKS: Good Well

RECEIVED
 DEC 22 1978

MISS. BD. OF WATER COMMISSIONERS

If well telescopes please sketch and show depths.

GROUND LEVEL

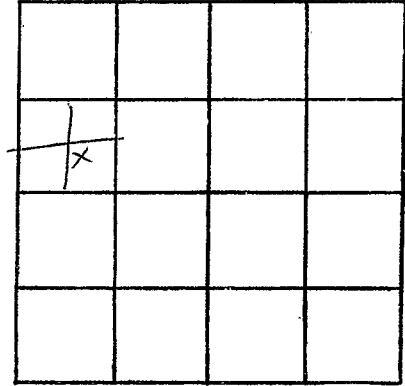

SECTION 20

Please indicate well location X.

ADDITIONAL INFORMATION

If more than one screen,
show locations of each on sketch.