

MARION  
 K 2025  
 11-06-78

MISSISSIPPI  
 BOARD OF WATER COMMISSIONERS  
 416 North State Street  
 Jackson, Mississippi 39201

WATER WELL DRILLERS LOG

Nov. 6 1978 News Wellers Marion  
 date well completed firm name county well located

LANDOWNER:  
 Austin Watson  
 P.O. box 447 Columbia  
 (mailing address)

description of formations encountered	from	to
sandy clay	0	25
Red sand	25	105
fine gravel & sand	105	122

WELL LOCATION:  
 sec. 29 T. 3 N R. 13 E  
 6 miles WSW of Kankou  
 (distance) (direction) (nearest town)

WELL PURPOSE: home  
 (home, irrigation, municipal, industrial)

WELL COMPLETION DATA:

(1) diameter (inches) 4"

(2) total depth (feet) 122

(3) static water level (feet) 96 below top of ground

(4) casing plastic bottom  
 (material) (depth)  
 (size) if telescope see back.

(5) screen 5' 117"  
 (length) (depth to top)  
 1/2" plastic  
 (size) (material)

(6) pump 1/2 HP 10  
 (HP) (yield gpm)  
 belt  
 (type power)

(7) electric log no  
 (yes or no)

(organization running log)


(8) how well bottom plugged  
 WOODEN PLUG

DRILLERS REMARKS:

Miss. Board of Water Comm.  
 FEB 15 1979  
 RECEIVED

If well telescopes please sketch and show depths.

GROUND LEVEL

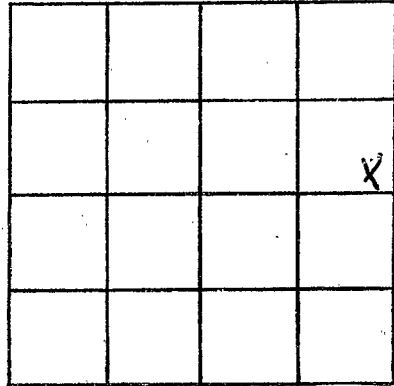

SECTION 29

Please indicate well location X.

ADDITIONAL INFORMATION

If more than one screen,  
show locations of each on sketch.