

MARION
K 2026
11-05-78

**MISSISSIPPI  
BOARD OF WATER COMMISSIONERS**  
416 North State Street  
Jackson, Mississippi 39201

**WATER WELL DRILLERS LOG**

11/5 1978 Hollinger Well Service Marion  
 date well completed firm name county well located

LANDOWNER:	description of formations encountered	from	to
Dorsey Holmes RT 3 Foxworth, MS (mailing address)			

**WELL LOCATION:**  
 sec. 17 T-30<sub>S</sub> R-19<sub>W</sub> 13<sub>E</sub>  
 3 miles W of Foxworth  
 (distance) (direction) (nearest town)

**WELL PURPOSE:**  
 (home, irrigation, municipal, industrial)

- WELL COMPLETION DATA:**
- (1) diameter (inches) 2"
  - (2) total depth (feet) 60
  - (3) static water level (feet) 13 (below above top of ground)
  - (4) casing pvc 50  
(material) (depth)  
(size) if telescope see back.
  - (5) screen 10 50  
(length) (depth to top)  
2" pvc  
(size) (material)
  - (6) pump 1/2 9  
(HP) (yield gpm)  
elect.  
(type power)
  - (7) electric log                       
(yes or no)  
    
(organization running log)
  - (8) how well bottom plugged sand  
SARK


DRILLERS REMARKS: Very Good

**RECEIVED**  
 DEC 22 1978

MISS. Bd. OF WATER COMM.

If well telescopes please sketch and show depths.

GROUND LEVEL

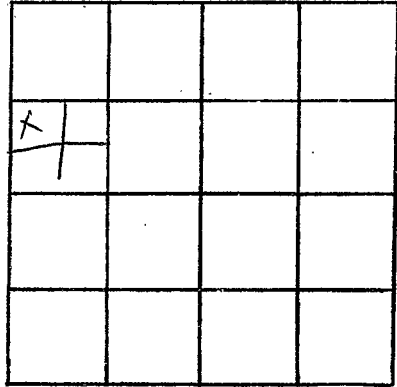

SECTION 17

Please indicate well location X.

ADDITIONAL INFORMATION

If more than one screen,  
show locations of each on sketch.