

MARION  
K 827  
11-09-78

MISSISSIPPI  
BOARD OF WATER COMMISSIONERS  
416 North State Street  
Jackson, Mississippi 39201

WATER WELL DRILLERS LOG

11-9 1978 TOM GRIFFITH  
date well completed firm name  
PLUMBING & WELL SERVICE, INC.  
Marion county well located

LANDOWNER:  
Mr. Leroy H. Bell  
Rt. 2 - Jopwood Miss.  
(mailing address)

description of formations encountered	from	to
Topsoil	0	2
Loam	2	140
Gravel	71	61
Sand	61	95

WELL LOCATION:  
sec. 34 T 3 N R 13 E  
S S W  
1/2 miles SW of Columbus  
(distance) (direction) (nearest town)

WELL PURPOSE: Home  
(home, irrigation, municipal, industrial)

WELL COMPLETION DATA:

(1) diameter (inches) 9.5 ft

(2) total depth (feet) 4"

(3) static water level (feet) 65 ft below top of ground.

(4) casing (material) plastic, (depth) 85, 4" (size) If telescope see back.

(5) screen (length) 10 ft, (depth to top) 85, 4" (size) plastic (material)


(6) pump (HP) 1 HP, (yield gpm) 15, Electric (type power)

(7) electric log No. (yes or no)

(organization running log)

(8) how well bottom plugged  
Back Wash Valve


DRILLERS REMARKS:

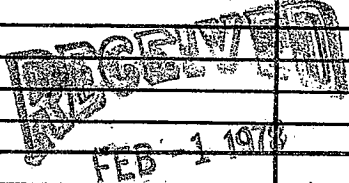

MISS. BD. OF WATER COMMISSIONERS

If well telescopes please sketch and show depths.

GROUND LEVEL

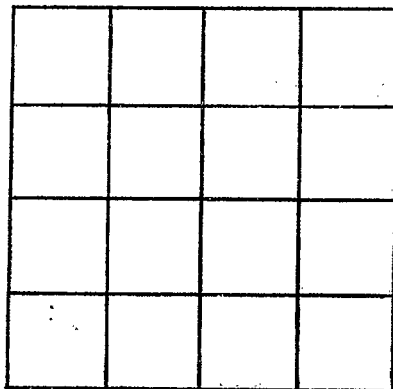

SECTION \_\_\_\_\_

Please indicate well location X.

ADDITIONAL INFORMATION

If more than one screen,  
show locations of each on sketch.