

MARION
K 2028
9-6-78

**MISSISSIPPI  
BOARD OF WATER COMMISSIONERS**  
416 North State Street  
Jackson, Mississippi 39201

**WATER WELL DRILLERS LOG**

**TOM GRIFFITH**

PLUMBING & WELL SERVICE, INC. *Marion*

320 MARLYSON AVE.

COLUMBIA, MS 39429

9-6-1978  
date well completed

county well located

**LANDOWNER:**

*Mike Reagan Powell*  
*Rt 1 - Box 77 Joplin*  
(mailing address) *Miss*

**description of formations encountered**

from to

<i>Top Soil</i>	<i>0</i>	<i>1</i>
<i>Sand &amp; gravel</i>	<i>1.8</i>	<i>3.7</i>
<i>Clay</i>	<i>3.7</i>	<i>4.5</i>
<i>Sand &amp; gravel</i>	<i>4.5</i>	<i>5.1</i>
<i>Sand</i>	<i>5.1</i>	<i>8.0</i>

**WELL LOCATION:**

sec. *17* T *3* N *135* R *22* E *W* S  
*3* miles *W* of *Joplin*  
(distance) (direction) (nearest town)

**WELL PURPOSE:** *Home*  
(home, irrigation, municipal, industrial)


**WELL COMPLETION DATA:**

- (1) diameter (inches) *2"*
- (2) total depth (feet) *80 ft.*
- (3) static water level (feet) *40 ft.* below above top of ground.
- (4) casing *plastic, 60 ft.*  
(material) (depth)  
*2"* (size) if telescope see back.
- (5) screen *20 ft, 60 ft.*  
(length) (depth, to top)  
*2"* (size) *plastic* (material)
- (6) pump *1 hp* *hard installed* as *9 1118178*  
(HP) (yield gpm)  
*Electric* (type power)
- (7) electric log *no*  
(yes or no)

(organization running log)

(8) how well bottom plugged  
*Back Wash Valve*


DRILLERS REMARKS:

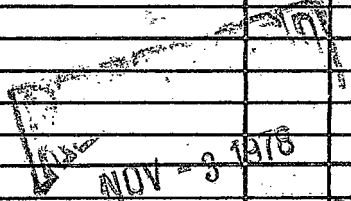

**MISS. BB. OF WATER COMMISSIONERS**

If well telescopes please sketch and show depths.

GROUND LEVEL

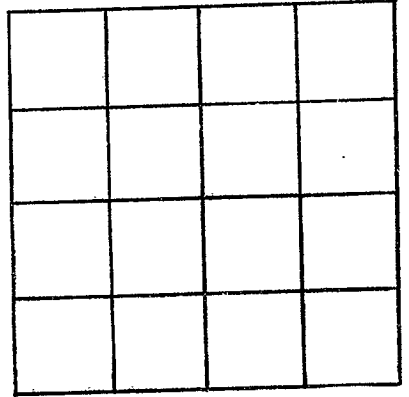

SECTION \_\_\_\_\_

Please indicate well location X.

ADDITIONAL INFORMATION

Lined area for additional information.

If more than one screen, show locations of each on sketch.