

MARION

K. 209

5/23/78

MISSISSIPPI BOARD OF WATER COMMISSIONERS 416 North State Street Jackson, Mississippi 39201

WATER WELL DRILLERS LOG

5/23

19 78

Hollingsworth Well Service

date well completed

firm name

county well located

LANDOWNER:

Jalain Hunt

description of formations encountered

from

to

RT 2

sand
chuck gravel
sand gravel

0 40
40 80
80 125

Foxworth, Gms.
(mailing address)

WELL LOCATION:

sec. 22 T. 3 N. R. 19 E. W.

1 miles S of Foxworth
(distance) (direction) (nearest town)

WELL PURPOSE:

Home
(home, irrigation, municipal, industrial)

WELL COMPLETION DATA:

- (1) diameter (inches) 2"
(2) total depth (feet) 125
(3) static water level (feet) 60 below top of ground
(4) casing pvc, 120 (material), (depth)
(size) if telescope see back.
(5) screen 5, 120 (length), (depth to top)
2, pvc (size), (material)
(6) pump 1 (HP), 8 (yield gpm)
elect (type power)
(7) electric log (yes or no)

(organization running log)

(8) how well bottom plugged sand SHARK


DRILLERS REMARKS: Very good

RECEIVED JUN 23 1978

MISS. BD. OF WATER COMM

If well telescopes please sketch and show depths.

GROUND LEVEL

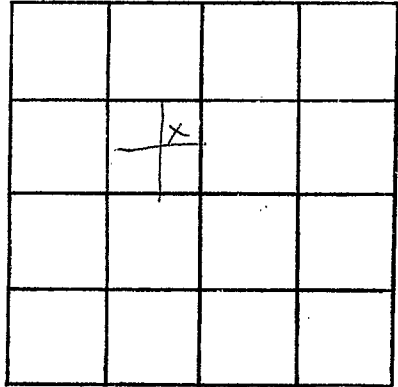

SECTION 22

Please indicate well location X.

ADDITIONAL INFORMATION

If more than one screen,
show locations of each on sketch.