

MARION
 K 2031
 3-18-78

MISSISSIPPI
 BOARD OF WATER COMMISSIONERS
 416 North State Street
 Jackson, Mississippi 39201

WATER WELL DRILLERS LOG

3/18 1978 W. J. Griffith Well Marion
 date well completed firm name county well located
Service

LANDOWNER:
Mrs. Helma Chishum
Rt. 3 Box 137 Jopworth
 (mailing address) Miss.

description of formations encountered	from	to
<u>top soil</u>	<u>0</u>	<u>2</u>
<u>clay</u>	<u>2</u>	<u>40</u>
<u>sand</u>	<u>40</u>	<u>100</u>

WELL LOCATION:
 sec. 33T 30S R. 13E
6 miles SW of Columbus
 (distance) (direction) (nearest town)

WELL PURPOSE: Home
 (home, irrigation, municipal, industrial)

- WELL COMPLETION DATA:
- diameter (inches) 4"
 - total depth (feet) 100 ft.
 - static water level (feet) _____ below/above top of ground.
 - casing Plastic 80 ft
 (material) (depth)
4" (size) If telescope see back.
 - screen 20 ft. 80 ft.
 (length) (depth to top)
4" (size) (material)
 - pump 3/4 HP
 (HP) (yield gpm)
Electric (type power)
 - electric log no
 (yes or no)
n/a
 (organization running log)
 - how well bottom plugged
B.W. Valve


RECEIVED
 APR 27 1978

DRILLERS REMARKS:

MISS. BD. OF WATER COMM.

If well telescopes please sketch and show depths.

GROUND LEVEL

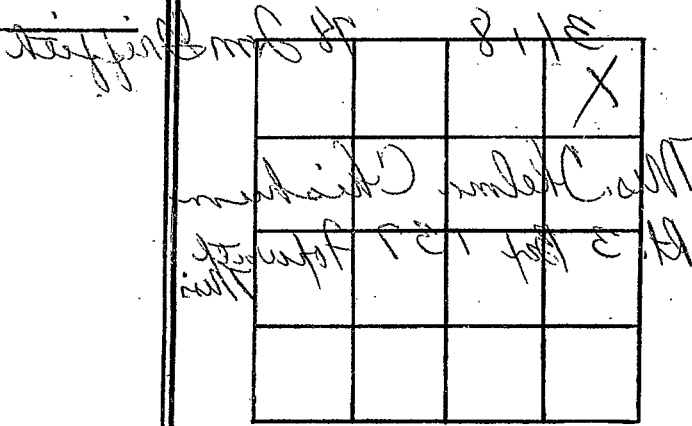

SECTION 33

Please indicate well location X.

ADDITIONAL INFORMATION

If more than one screen,
show locations of each on sketch.