

MARION  
 K 2032  
 3-15-78

MISSISSIPPI  
 BOARD OF WATER COMMISSIONERS  
 416 North State Street  
 Jackson, Mississippi 39201

WATER WELL DRILLERS LOG

3/15/78 date well completed  
 1978 Tom Griffin Well firm name  
 Marion county well located

LANDOWNER:

M. Alton Simmons  
 Rt. 1 Box 291 Poplarville  
 (mailing address) Miss.

description of formations encountered

description of formations encountered	from	to
top soil	0	1
clay	1	20
sandy & gravel	20	24

WELL LOCATION:

sec. 1 T. 30<sup>N</sup> R. 19<sup>E</sup>  
 6 miles W of Columbia  
 (distance) (direction) (nearest town)

WELL PURPOSE:

house  
 (home, irrigation, municipal, industrial)

WELL COMPLETION DATA:


- (1) diameter (inches) 2"
- (2) total depth (feet) 24 ft
- (3) static water level (feet) \_\_\_\_\_ below/above top of ground.
- (4) casing plastic 74 ft (material) (depth)  
 2" (size) if telescope see back.
- (5) screen 10 ft. 14 ft (length) (depth to top)  
 2" plastic (size) (material)
- (6) pump No pump (HP) (yield gpm)  
 Electric (type power)
- (7) electric log no (yes or no)  
 n/a (organization running log)
- (8) how well bottom plugged B.W. Valve

DRILLERS REMARKS:

RECEIVED  
 APR 27 1978

If well telescopes please sketch and show depths.

GROUND LEVEL

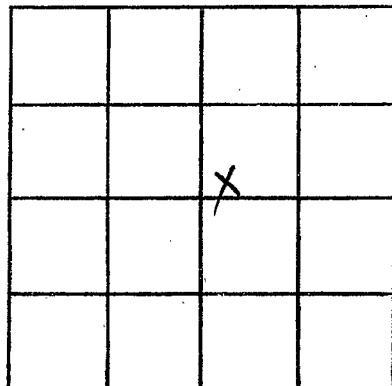

SECTION 1

Please indicate well location X.

ADDITIONAL INFORMATION

If more than one screen,  
show locations of each on sketch.