

MARTON
K 233
2-16-78

MISSISSIPPI
 BOARD OF WATER COMMISSIONERS
 416 North State Street
 Jackson, Mississippi 39201

WATER WELL DRILLERS LOG

2/16 1978 Hollinger Well S. MARTON
 date well completed firm name county well located

LANDOWNER: Jim Holmes
 P.O. Box 667
 Columbia, Ms.
 (mailing address)

description of formations encountered	from	to
clay	0	20
20-60 sand & gravel	20	60

WELL LOCATION:
 sec. 18 T3 N R 19 E
 S 13E
 4 miles W of Foxworth
 (distance) (direction) (nearest town)

WELL PURPOSE: Home
 (home, irrigation, municipal, industrial)

WELL COMPLETION DATA:

(1) diameter (inches) 2"

(2) total depth (feet) 60

(3) static water level (feet) 20 (below above top of ground)

(4) casing PVC (material), (depth) (size) if telescope see back.

(5) screen 5 55 (length) (depth to top)

2 PVC (size) (material)

(6) pump 1/2 8 (HP) (yield gpm)

elect (type power)

(7) electric log (yes or no)

(organization running log)

(8) how well bottom plugged sand shale


DRILLERS REMARKS: good well

RECEIVED
 MAY 8 - 1978

MISS. BD. OF WATER COMMISSIONERS

If well telescopes please sketch and show depths.

GROUND LEVEL

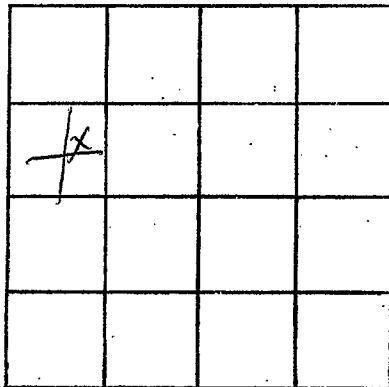

SECTION 18

Please indicate well location X.

ADDITIONAL INFORMATION

Lined area for additional information.

If more than one screen, show locations of each on sketch.