

MARION
 K 2034
 3-10-78

MISSISSIPPI
 BOARD OF WATER COMMISSIONERS
 416 North State Street
 Jackson, Mississippi 39201

WATER WELL DRILLERS LOG

3/10 1978 Hollinsworth's Well S. Marion
 date well completed firm name county well located

LANDOWNER:	description of formations encountered	from	to
MIC DAVIS RT1			
Foxworth, Ms. (mailing address)	CLAY, GRAVEL SAND, GRAVEL	0	150 245

WELL LOCATION:
 sec 6 T 30 N R 19 E 13E
 S W
 5 miles W of Foxworth
 (distance) (direction) (nearest town)

WELL PURPOSE: Home
 (home, irrigation, municipal, industrial)

WELL COMPLETION DATA:

(1) diameter (inches) 4"

(2) total depth (feet) 245

(3) static water level (feet) 150 below top of ground

(4) casing PVC, 245 (material) (depth)
 (size) if telescope see back.

(5) screen 10, 235 (length) (depth to top)
 4, PVC (size) (material)

(6) pump 1, 12 (HP) (yield gpm)
 elect (type power)

(7) electric log (yes or no)

(organization running log)

(8) how well bottom plugged sand SHARK


DRILLERS REMARKS: very good

RECEIVED
 MAY 8 - 1978

MISS. BD. OF WATER COMMISSIONERS

If well telescopes please sketch and show depths.

GROUND LEVEL

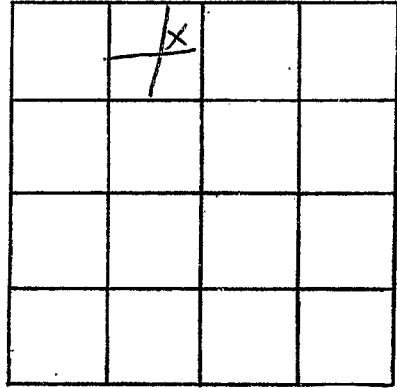

SECTION 6

Please indicate well location X.

ADDITIONAL INFORMATION

If more than one screen,
show locations of each on sketch.