

MARION  
 K 2035  
 10/20/17

MISSISSIPPI  
 BOARD OF WATER COMMISSIONERS  
 416 North State Street  
 Jackson, Mississippi 39201

WATER WELL DRILLERS LOG

10/20 19 97 Hollinsworth Well Serv. MARION  
 date well completed firm name county well located

LANDOWNER: Charles Payton  
 RT 3  
 Foxworth, MS 39483  
 (mailing address)

description of formations encountered	from	to
Clay, chalk, gravel	0	80
sand, gravel	80	120

WELL LOCATION:  
 sec. 19 T. 3 N. R. 13 E  
 S W  
 2 miles N of Foxworth  
 (distance) (direction) (nearest town)

WELL PURPOSE: Home  
 (home, irrigation, municipal, industrial)

WELL COMPLETION DATA:  
 (1) diameter (inches) 2"  
 (2) total depth (feet) 120 ft.  
 (3) static water level (feet) 80 below top of ground.  
 (4) casing PVC 115 (material) (depth)  
 (size) if telescope see back.  
 (5) screen 5 115 (length) (depth to top)  
 2" PVC (size) (material)  
 (6) pump 1 HP 8 (HP) (yield gpm)  
 elect (type power)  
 (7) electric log (yes or no)  
 (organization running log)

(8) how well bottom plugged sand  
 sharp


DRILLERS REMARKS: good well

RECEIVED  
 NOV 20 1917

MISS. BD. OF WATER COMM

If well telescopes please sketch and show depths.

GROUND LEVEL

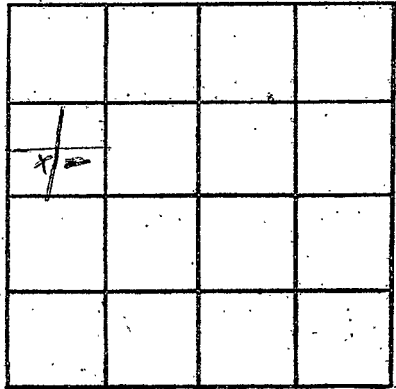

SECTION 19

Please indicate well location X.

ADDITIONAL INFORMATION

Lined area for additional information.

If more than one screen, show locations of each on sketch.