

MARION  
 K 2026  
 2-16-18

MISSISSIPPI  
 BOARD OF WATER COMMISSIONERS  
 416 North State Street  
 Jackson, Mississippi 39201

WATER WELL DRILLERS LOG

2-16-74 1978 Tom Griffith Well Marion  
 date well completed firm name Service county well located

LANDOWNER:

Mr. John Robertson  
 Rt. 1 Box 260 Poplar  
 (mailing address) Miss

description of formations encountered

from to

Top Soil	0	2
Clay	2	70
Chalk	70	110
Sand & gravel	110	150

WELL LOCATION:

sec. 8 T 30 S R 135 E  
 4 miles W of Columbus  
 (distance) (direction) (nearest town)

WELL PURPOSE:

Home  
 (home, irrigation, municipal, industrial)

WELL COMPLETION DATA:

- (1) diameter (inches) 2"
- (2) total depth (feet) 150 ft
- (3) static water level (feet) 150 ft below top of ground
- (4) casing (material) plastic (depth) 140 ft  
 2" (size) if telescope see back.
- (5) screen (length) 10 ft (depth to top) 140 ft  
 2" (size) plastic (material)
- (6) pump 1 Hp (HP) (yield gpm)  
 Electric (type power)
- (7) electric log no (yes or no)  
 n/a (organization running log)
- (8) how well bottom plugged B.W. Valve


DRILLERS REMARKS:

RECEIVED  
 APR 27 1978

MISS. BD. OF WATER COMM

If well telescopes please sketch and show depths.

GROUND LEVEL

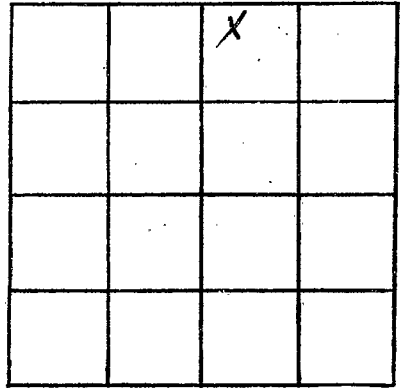

SECTION 8

Please indicate well location X.

ADDITIONAL INFORMATION

If more than one screen,  
show locations of each on sketch.