

MARION

2037

8-30-78

MISSISSIPPI BOARD OF WATER COMMISSIONERS 416 North State Street Jackson, Mississippi 39201

WATER WELL DRILLERS LOG

8/30 1978 Holmberg Well 5. Marion date well completed firm name county well located

LANDOWNER: Robert S. Holms Rt 1 Kokomo, MS. (mailing address) WELL LOCATION: sec. 24 T. 30 N S R. 19 E W 5 miles N of Kokomo (distance) (direction) (nearest town)

Table with 3 columns: description of formations encountered, from, to. Row 1: clay, chalk, 0, 70. Row 2: water sand, 70, 127.

WELL PURPOSE: Home (home, irrigation, municipal, industrial)

- WELL COMPLETION DATA: (1) diameter (inches) 2" (2) total depth (feet) 127 (3) static water level (feet) 70 below above top of ground. (4) casing PVC 122 (material) (depth) (size) if telescope see back. (5) screen 5ft, 122 (length) (depth to top) 2" PVC (size) (material) (6) pump 1 (HP) (yield gpm) elect (type power) (7) electric log (yes or no) (organization running log) (8) how well bottom plugged sand SHOCK


DRILLERS REMARKS: good well

RECEIVED OCT 12 1978

MISS. BD. OF WATER COMMISSIONERS

If well telescopes please sketch and show depths.

GROUND LEVEL

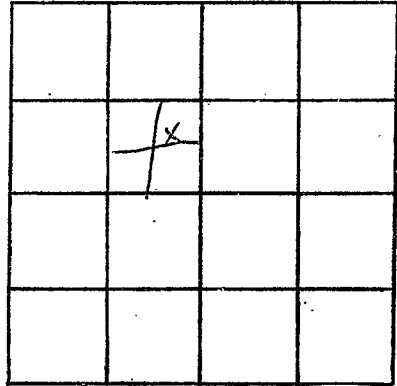

SECTION 24

Please indicate well location X.

ADDITIONAL INFORMATION

If more than one screen,
show locations of each on sketch.