

MARION
K 2038
8-28-78

**MISSISSIPPI
BOARD OF WATER COMMISSIONERS**
416 North State Street
Jackson, Mississippi 39201

WATER WELL DRILLERS LOG

8/28 1978 Hollings Well S. MARION
 date well completed firm name county well located

LANDOWNER:	description of formations encountered	from	to
<u>Siston Forbes</u> <u>RT 2 Box 352</u> <u>Foxworth Ms</u> (mailing address)			

WELL LOCATION:
 sec. 7 T 3 (N) R 18 E
6 miles W of Foxworth
 (distance) (direction) (nearest town)

WELL PURPOSE:
 (home, irrigation, municipal, industrial)

WELL COMPLETION DATA:

(1) diameter (inches) 2"

(2) total depth (feet) 120

(3) static water level (feet) 70 below above top of ground.

(4) casing PVC, 110,
 (material) (depth)
 (size) if telescope see back.

(5) screen 10, 110
 (length) (depth to top)
2", PVC
 (size) (material)

(6) pump 1, 8
 (HP) (yield gpm)
elect
 (type power)

(7) electric log _____
 (yes or no)

 (organization running log)

(8) how well bottom plugged sand
SHARK


DRILLERS REMARKS: Very good

RECEIVED
 OCT 12 1978

MISS. BD. OF WATER COMMISSIONERS

If well telescopes please sketch and show depths.

GROUND LEVEL

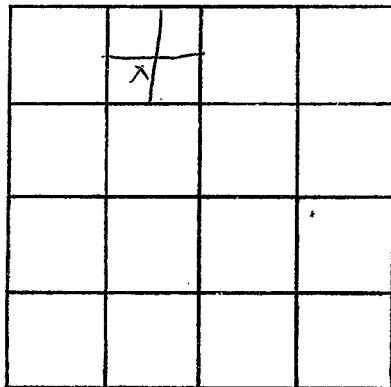

SECTION 7

Please indicate well location X.

ADDITIONAL INFORMATION

If more than one screen,
show locations of each on sketch.