

MARION  
 K 2039  
 7-17-78

MISSISSIPPI  
 BOARD OF WATER COMMISSIONERS  
 416 North State Street  
 Jackson, Mississippi 39201

WATER WELL DRILLERS LOG

TOM GRIFFITH

7-17-78  
 date well completed

PLUMBING & WELL SERVICE, INC.  
 firm name

Marion  
 county well located


LANDOWNER:	description of formations encountered	from	to
Mr. Joe Carroll	Top Soil	0	2
P.O. Box 251 - Fofwater	Shale	2	15
(mailing address) Miss	Gravel	15	42
	Chalk	42	60
	Sand	60	100
WELL LOCATION:			
sec. 20 T 3 N R 13 E			
S W			
2 miles W of Fofwater			
(distance) (direction) (nearest town)			
WELL PURPOSE: Home			
(home, irrigation, municipal, industrial)			
WELL COMPLETION DATA:			
(1) diameter (inches) 4"			
(2) total depth (feet) 100 ft			
(3) static water level (feet) 65 ft below top of ground			
(4) casing plastic 90 ft			
(material) (depth)			
4" if telescope see back.			
(size)			
(5) screen 10 ft 90 ft			
(length) (depth to top)			
4" plastic			
(size) (material)			
(6) pump 3/4 HP 650 gpm			
(HP) (yield gpm)			
Electric			
(type power)			
(7) electric log no			
(yes or no)			
(organization running log)			
(8) how well bottom plugged			
Back Wash Valve			
DRILLERS REMARKS:			

RECEIVED  
 SEP - 8 1978

MISS. BD. OF WATER COMMISSIONERS

If well telescopes please sketch and show depths.

GROUND LEVEL

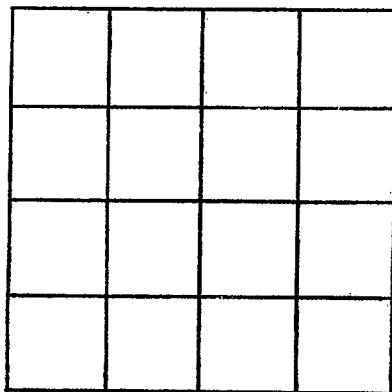

SECTION \_\_\_\_\_

Please indicate well location X.

ADDITIONAL INFORMATION

If more than one screen,  
show locations of each on sketch.