

MARION
 K 2040
 7-8-78

MISSISSIPPI
 BOARD OF WATER COMMISSIONERS
 416 North State Street
 Jackson, Mississippi 39201

WATER WELL DRILLERS LOG

7/8 1978
 date well completed

TOM GRIFFITH
 PLUMBING & WELL SERVICE, INC.

Marion
 county well located

LANDOWNER:

Mr. Connie Mc Daniel
 Rt. 1 - Goshworth, Miss.
 (mailing address)

description of formations encountered

from to

Top Soil	0	2
Clay	2	12
Gravel	12	48
Sand	4	60
Chalk	60	94
Subst. gravel	94	130
Sand	130	170

WELL LOCATION:

sec. 9 T. 3 N. R. 19 E. 13E
 S W
 3 miles W of Goshworth
 (distance) (direction) (nearest town)

WELL PURPOSE:

Home
 (home, irrigation, municipal, industrial)

WELL COMPLETION DATA:

- (1) diameter (inches) 2"
- (2) total depth (feet) 170 ft
- (3) static water level (feet) 140 ft below top of ground.
- (4) casing plastic 170 ft (material) (depth)
 2" (size) if telescope see back.
- (5) screen 1 ft., 100 ft. (length) (depth to top)
 2" (size) plastic (material)
- (6) pump 1 hp 240 gpm (HP) (yield gpm)
 Electric (type power)
- (7) electric log No (yes or no)

(organization running log)

(8) how well bottom plugged Back Wash Valve


DRILLERS REMARKS:

RECEIVED
 SEP - 8 1978

MISS. BD. OF WATER COMMISSIONERS

If well telescopes please sketch and show depths.

GROUND LEVEL

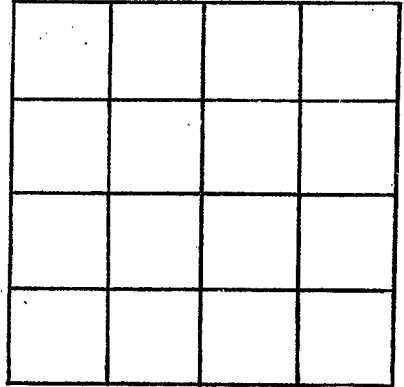

SECTION _____

Please indicate well location X.

ADDITIONAL INFORMATION

If more than one screen,
show locations of each on sketch.