

MARION
 K 2041
 7-17-78

MISSISSIPPI
 BOARD OF WATER COMMISSIONERS
 416 North State Street
 Jackson, Mississippi 39201

WATER WELL DRILLERS LOG

TOM GRIFFITH

PLUMBING & WELL SERVICE, INC.

Marion
 county well located

7-17
 date well completed

LANDOWNER:

Mr. Avery Fortenberry
 Rt. 3 Box 235 - Poplarville
 (mailing address) Miss.

description of formations encountered

from to

Top Soil	0	3
Clay Sand	3	14
Gravel	14	32
Sand	32	60
Coarse Gravel	60	170
Sand	170	185

WELL LOCATION:

sec. 20 T 3 N R 13 E
 S W
 2 miles S of Poplarville
 (distance) (direction) (nearest town)

WELL PURPOSE: Home
 (home, irrigation, municipal, industrial)


WELL COMPLETION DATA:

- (1) diameter (inches) 2"
- (2) total depth (feet) 185 ft
- (3) static water level (feet) 155 ft below top of ground.
- (4) casing plastic 90 ft (material) (depth)
 2" if telescope see back. (size)
- (5) screen 10 ft 90 ft (length) (depth to top)
 2" plastic (size) (material)
- (6) pump 1 HP 250 gpm (HP) (yield gpm)
 Elec (type power)
- (7) electric log No (yes or no)

(organization running log)

(8) how well bottom plugged
 Back Check Valve


DRILLERS REMARKS:

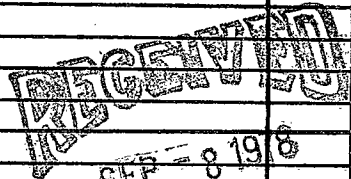

MISS. BD. OF WATER COMM.

If well telescopes please sketch and show depths.

GROUND LEVEL

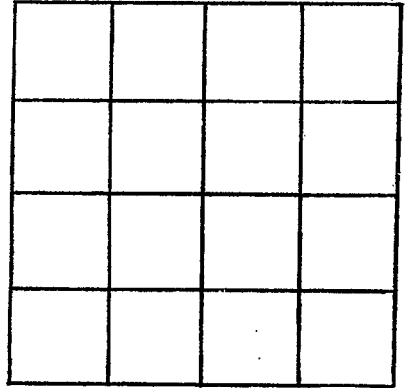

SECTION _____

Please indicate well location X.

ADDITIONAL INFORMATION

If more than one screen,
show locations of each on sketch.