

MARION  
 K 2042  
 8-24-78

MISSISSIPPI  
 BOARD OF WATER COMMISSIONERS  
 416 North State Street  
 Jackson, Mississippi 39201  
 WATER WELL DRILLERS LOG

Aug 24 1978 date well completed  
 TOM GRIFFITH  
 PLUMBING & WELL SERVICE, INC.  
 Marion county well located

LANDOWNER:  
 Mr. Shirley May  
 (mailing address)

WELL LOCATION:  
 sec. 21 T. 3 N. R. 19 E. S. 136  
 2 miles W of Falkland  
 (distance) (direction) (nearest town)

WELL PURPOSE: Home  
 (home, irrigation, municipal, industrial)

WELL COMPLETION DATA:

(1) diameter (inches) 4"

(2) total depth (feet) 200 ft -

(3) static water level (feet) 160 ft below top of ground.

(4) casing (material) plastic (depth) 80 ft  
 4" (size) if telescope see back.

(5) screen (length) 20 ft (depth to top) 80 ft  
 4" (size) plastic (material)

(6) pump 3/4 HP (HP) 700 gpm (yield gpm)  
 Electric (type power)

(7) electric log no (yes or no)

(organization running log)

(8) how well bottom plugged Back Wash Valve

description of formations encountered	from	to
Top soil	0	1
clay	1	18
Sand & gravel	18	41
Gravel	4	52
Chalk	52	120
Sand	120	132
Gravel	132	160
Sand	160	200

RECEIVED


SEP 8 1978

MISS. BD. OF WATER COMM.

DRILLERS REMARKS:

If well telescopes please sketch and show depths.

GROUND LEVEL

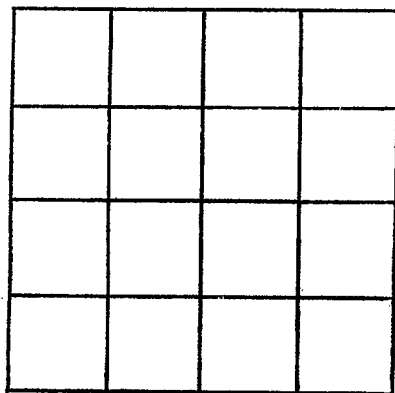

SECTION \_\_\_\_\_

Please indicate well location X.

ADDITIONAL INFORMATION

If more than one screen,  
show locations of each on sketch.