

MARION  
K 2043  
5-30-78

MISSISSIPPI  
BOARD OF WATER COMMISSIONERS  
416 North State Street  
Jackson, Mississippi 39201

WATER WELL DRILLERS LOG

5-30 19 78 TOM GRIFFITH  
date well completed PLUMBING & WELL SERVICE, INC. county well located

LANDOWNER:  
Mr. Gero Dillon  
  
(mailing address)  
  
WELL LOCATION:  
sec. 23 T-30 N R-19 E 13E  
1 miles S of Florence  
(distance) (direction) (nearest town)

description of formations encountered	from	to
<u>top soil</u>	<u>0</u>	<u>1</u>
<u>clay</u>	<u>1</u>	<u>20</u>
<u>shell</u>	<u>20</u>	<u>30</u>
<u>sand</u>	<u>30</u>	<u>100</u>

WELL PURPOSE: Home  
(home, irrigation, municipal, industrial)

- WELL COMPLETION DATA:
- (1) diameter (inches) 2"
  - (2) total depth (feet) 100 ft
  - (3) static water level (feet) 110 ft below top of ground.
  - (4) casing Plastic 90 ft.  
(material) (depth)  
2"  
(size) if telescope see back.
  - (5) screen 10 ft 90 ft.  
(length) (depth to top)  
2" Plastic  
(size) (material)
  - (6) pump 1 HP 10  
(HP) (yield gpm)  
Electric  
(type power)
  - (7) electric log No  
(yes or no)
- (organization running log)
- (8) how well bottom plugged B. W. Valve


RECEIVED

JUN 30 1978

DRILLERS REMARKS:

If well telescopes please sketch and show depths.

GROUND LEVEL

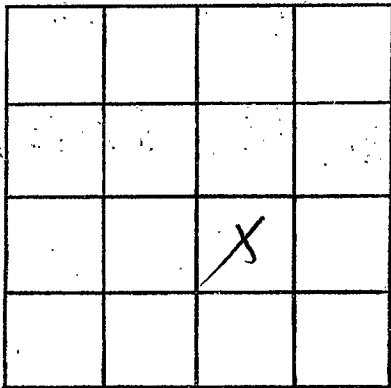

SECTION 23

Please indicate well location X.

ADDITIONAL INFORMATION

Lined area for additional information.

If more than one screen, show locations of each on sketch.