

MARION

K 2045

MISSISSIPPI BOARD OF WATER COMMISSIONERS
416 North State Street
Jackson, Mississippi 39201

WATER WELL DRILLERS LOG

5/23/78 19
date well completed

Hollister Well Service
firm name

MARION
county well located

LANDOWNER: Karl Strinsen

description of formations encountered

from

to

Rt 2 Box 207

Foxworth, Ms.
(mailing address)

C/M, gravel
sand

0 60
60 100

WELL LOCATION:

sec. 9 T 30 N R 14 E
3 miles W of New Hope
(distance) (direction) (nearest town)

WELL PURPOSE: Home
(home, irrigation, municipal, industrial)

WELL COMPLETION DATA:

- (1) diameter (inches) 2"
- (2) total depth (feet) 100
- (3) static water level (feet) 35 ^{below} above top of ground.
- (4) casing PVC, 95,
(material) (depth)
2" if telescope see back.
(size)
- (5) screen 5, 95
(length) (depth to top)
2", PVC
(size) (material)
- (6) pump 1/2, 8
(HP) (yield gpm)
elect
(type power)
- (7) electric log
(yes or no)

(organization running log)

(8) how well bottom plugged sand
shark


DRILLERS REMARKS: very good well

RECEIVED
JUN 23 1978

MISS. BD. OF WATER COMM

If well telescopes please sketch and show depths.

GROUND LEVEL

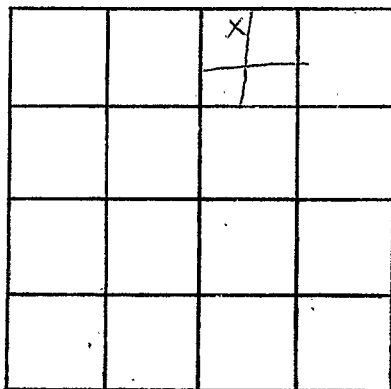

SECTION 9

Please indicate well location X.

ADDITIONAL INFORMATION

If more than one screen,
show locations of each on sketch.