

MARTON

K 2046

5-5-78

MISSISSIPPI BOARD OF WATER COMMISSIONERS 416 North State Street Jackson, Mississippi 39201

WATER WELL DRILLERS LOG

5/5/78 19 Hollinger Well Service firm name Marton county well located

LANDOWNER: John McHanna RT 2

description of formations encountered	from	to
Chalk Sand, Gravel	0	80
Sand, Pea Gravel	80	120

Foxworth, Ms (mailing address)

WELL LOCATION: sec 36 T 36 N R 18 E W 1 miles AT of Tamestawn (distance) (direction) (nearest town)


WELL PURPOSE: Home (home, irrigation, municipal, industrial)

- WELL COMPLETION DATA:
- (1) diameter (inches) 2"
  - (2) total depth (feet) 120
  - (3) static water level (feet) 80 below top of ground.
  - (4) casing PVC, 115 (material), (depth)
  - (size) if telescope see back.
  - (5) screen 5, 115 (length), (depth to top)
  - 2", PVC (size), (material)
  - (6) pump 1, 9 (HP), (yield gpm)
  - elect. (type power)
  - (7) electric log (yes or no)

(organization running log)


(8) how well bottom plugged sand SHARK

DRILLERS REMARKS: Very good

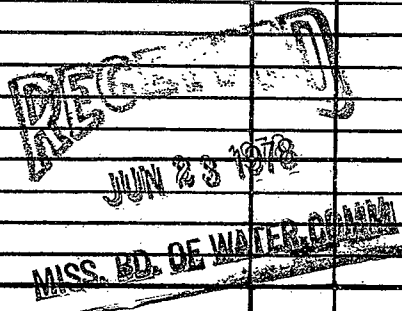

If well telescopes please sketch and show depths.

GROUND LEVEL

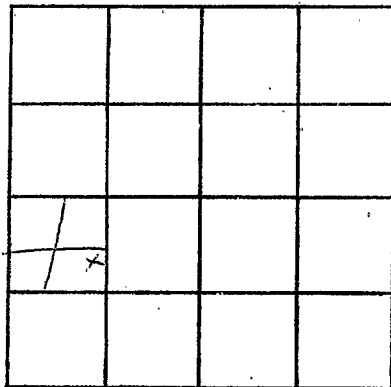

SECTION 36

Please indicate well location X.

ADDITIONAL INFORMATION

If more than one screen,  
show locations of each on sketch.