

MARION
K 247
9-28-78

**MISSISSIPPI  
BOARD OF WATER COMMISSIONERS**  
416 North State Street  
Jackson, Mississippi 39201

**WATER WELL DRILLERS LOG**

9/28 1978 Hollis Wells MARION  
 date well completed firm name county well located

LANDOWNER: Ima Lu Ford  
Rt 2 Foxworth  
MS.  
 (mailing address)

description of formations encountered	from	to
chalk, clay	0	50
chalk, gravel	50	100
pen gravel	100	145

WELL LOCATION:  
 sec. 16 T. 30 N. R. 19 E  
 S W  
2 miles W of Foxworth  
 (distance) (direction) (nearest town)

WELL PURPOSE: Home  
 (home, irrigation, municipal, industrial)

WELL COMPLETION DATA:

(1) diameter (inches) 2"

(2) total depth (feet) 145

(3) static water level (feet) 80 below above top of ground.

(4) casing pvc, 140,  
 (material) (depth)  
 (size) if telescope see back.

(5) screen 5, 140  
 (length) (depth to top)  
2, pvc  
 (size) (material)

(6) pump 1, 7  
 (HP) (yield gpm)  
elect  
 (type power)

(7) electric log \_\_\_\_\_  
 (yes or no)

\_\_\_\_\_  
 (organization running log)

(8) how well bottom plugged sand  
SHARK

DRILLERS REMARKS: Very good well


**RECEIVED**  
 ALL

OCT 12 1978

MISS. BD. OF WATER COMMISSIONERS

If well telescopes please sketch and show depths.

GROUND LEVEL

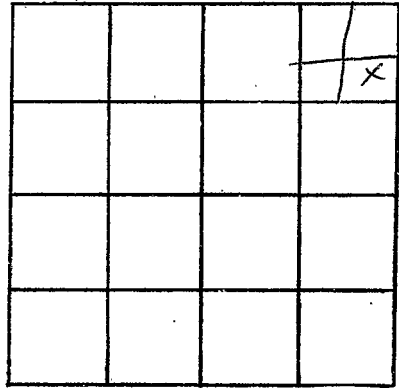

SECTION 16

Please indicate well location X.

ADDITIONAL INFORMATION

A series of horizontal lines for writing additional information, starting below the 'ADDITIONAL INFORMATION' header and extending to the bottom of the page.

If more than one screen, show locations of each on sketch.