

MARION  
 K 248  
 6-21-79  
 June 21

MISSISSIPPI  
 BOARD OF WATER COMMISSIONERS  
 416 North State Street  
 Jackson, Mississippi 39201

WATER WELL DRILLERS LOG

date well completed

firm name

county well located

1979 *Reynolds* Marion


LANDOWNER:	description of formations encountered	from	to
(mailing address)			
<i>Mrs Bertha Gault</i>	<i>clay &amp; gravel</i> <i>Red sand</i> <i>Red sand &amp; gravel</i> <i>Blue Chalk</i> <i>fine sand</i> <i>pea gravel &amp; sand</i>	0	24
<i>At 1 Fogworth miss</i>		24	65
		65	90
		90	160
		160	185
		185	200
WELL LOCATION: <i>13 E</i>			
sec. <i>31</i> T. <i>3</i> N R. <i>19 E</i>			
<i>4 1/2</i> miles <i>W.S.W.</i> of <i>Fogworth</i>			
(distance) (direction) (nearest town)			
WELL PURPOSE: <i>house</i>			
(home, irrigation, municipal, industrial)			
WELL COMPLETION DATA:			
(1) diameter (inches) <i>4 1/2"</i>			
(2) total depth (feet) <i>200'</i>			
(3) static water level (feet) <i>90</i> <small>below above</small> top of ground			
(4) casing <i>plastic bottom</i>			
(material) (depth)			
<input checked="" type="checkbox"/> If telescope see back.			
(size)			
(5) screen <i>5"</i> <i>195'</i>			
(length) (depth to top)			
<i>4 1/2"</i> <i>plastic</i>			
(size) (material)			
(6) pump <i>3/4"</i> <i>1.0</i>			
(HP) (yield gpm)			
<i>elect</i>			
(type power)			
(7) electric log <i>no</i>			
(yes or no)			
(organization running log)			
(8) how well bottom plugged <i>wooden plug</i>			
DRILLERS REMARKS:			

DEPT. OF NATURAL RESOURCES  
 BUREAU OF LAND & WATER RESOURCES

JAN 22 1980  
 RECEIVED

If well telescopes please sketch and show depths.

GROUND LEVEL

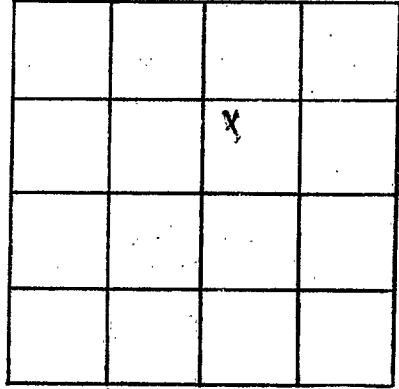

SECTION 31

Please indicate well location X.

ADDITIONAL INFORMATION

If more than one screen,  
show locations of each on sketch.