

Marion
K 2050
11-15-79

MISSISSIPPI
BOARD OF WATER COMMISSIONERS
416 North State Street
Jackson, Mississippi 39201

WATER WELL DRILLERS LOG

11-15 1979 Hollinger Marion
date well completed firm name county well located

LANDOWNER: Sam Egzell
Rt 2
Foxworth Ms
(mailing address)

description of formations encountered	from	to
sand gravel	0	100
fine gravel	100	127

WELL LOCATION:
sec. 20 T 30 N R 17 E
S 3
2 miles W of Foxworth
(distance) (direction) (nearest town)

WELL PURPOSE: Home
(home, irrigation, municipal, industrial)

- WELL COMPLETION DATA:
- (1) diameter (inches) 2
 - (2) total depth (feet) 127
 - (3) static water level (feet) 80 below above top of ground.
 - (4) casing pvc 122 (material) (depth)
 - (size) if telescope see back.
 - (5) screen 5 122 (length) (depth to top)
 - (size) (material) 2 pvc
 - (6) pump 1 6 (HP) (yield gpm)
 - elect (type power)
 - (7) electric log (yes or no)

(organization running log)

(8) how well bottom plugged sand
5 HOKK

DRILLERS REMARKS: Very good well


DEPT. OF NATURAL RESOURCES
BUREAU OF LAND & WATER RESOURCES

JAN 15 1980

RECEIVED

If well telescopes please sketch and show depths.

GROUND LEVEL

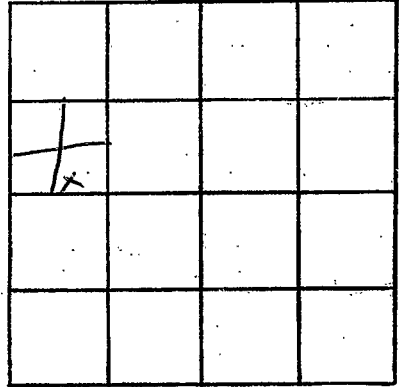

SECTION 20

Please indicate well location X.

ADDITIONAL INFORMATION

If more than one screen, show locations of each on sketch.