

Marion  
K 251

MISSISSIPPI  
BOARD OF WATER COMMISSIONERS  
416 North State Street  
Jackson, Mississippi 39201

11-15-79

WATER WELL DRILLERS LOG

11-15-79 19

Tom Huffaker  
firm name

Marion  
county well located

LANDOWNER:	description of fomations encountered	from	to
Churkey Lee Foxworth, Ms. (mailing address)			
WELL LOCATION: sec. 14 T. 3 (N) S. R. 10 E City/Town (distance) miles Dean town of Foxworth (direction) (nearest town)			
WELL PURPOSE: Home (home, irrigation, municipal, Industrial)			
WELL COMPLETION DATA:			
(1) diameter (inches) 4"			
(2) total depth (feet) 65'			
(3) static water level (feet) 20' below top of ground.			
(4) casing Plastic, 45' (material) (depth) 4" If telescope see back. (size)			
(5) screen 20' 45' (length) (depth to top) 4" Plastic (size) (material)			
(6) pump 1 (HP) NO (yield gpm) Elect (type power)			
(7) electric log NO (yes or no) NONE (organization running log)			
(8) how well bottom plugged B.C.V.			
DRILLERS REMARKS:			


DEPT. OF NATURAL RESOURCES  
BUREAU OF LAND & WATER RESOURCES

JAN 7 1980

RECEIVED

If well telescopes please sketch and show depths.

GROUND LEVEL

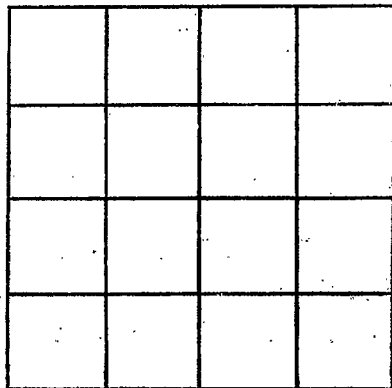

SECTION \_\_\_\_\_

Please indicate well location X.

**ADDITIONAL INFORMATION**

If more than one screen, show locations of each on sketch.