

Marion
R 2052
7-20-79

MISSISSIPPI
BOARD OF WATER COMMISSIONERS
416 North State Street
Jackson, Mississippi 39201

WATER WELL DRILLERS LOG

7-20 1979 Hollinger Wells. Marion
date well completed firm name county well located

LANDOWNER: Jerry Slocum
Hwy 98 W.
Foxworth
(mailing address)

description of formations encountered	from	to
SAND GRAVEL	0	60
CHALK	60	100
PEA GRAVEL	100	127

WELL LOCATION:
sec. 19 T 3 N R 19 13 E
S W E
3/4 miles W of Foxworth
(distance) (direction) (nearest town)

WELL PURPOSE: BUSINESS
(home, irrigation, municipal, industrial)

- WELL COMPLETION DATA:
- (1) diameter (inches) 2"
 - (2) total depth (feet) 127
 - (3) static water level (feet) 60 below top of ground.
 - (4) casing PVC 122 (material) (depth)
 - (size) if telescope see back.
 - (5) screen 5 122 (length) (depth to top)
 - 2 PVC (size) (material)
 - (6) pump 1 12 (HP) (yield gpm)
 - elect (type power)
 - (7) electric log (yes or no)

(organization running log)


(8) how well bottom plugged sand SHALE

DRILLERS REMARKS: Good well

pled 9-21/79
Dnr. LW

If well telescopes please sketch and show depths.

GROUND LEVEL

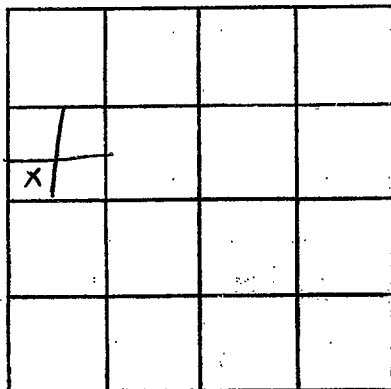

SECTION 19

Please indicate well location X.

ADDITIONAL INFORMATION

If more than one screen, show locations of each on sketch.