

MAYION
R
2053
8-15-79

MISSISSIPPI
BOARD OF WATER COMMISSIONERS
416 North State Street
Jackson, Mississippi 39201


WATER WELL DRILLERS LOG

8-15 1979 Hollinger MAYION
date well completed firm name county well located

| LANDOWNER: <u>Vernon Curtis</u> | description of formations encountered | from | to |
|---|---------------------------------------|----------|------------|
| RT1 | | | |
| Foxworth, Ms (mailing address) | sand, gravel pea, gravel | 0 160 | 160 205 |
| WELL LOCATION: | | | |
| sec. <u>2-T-30</u> <u>N</u> R. <u>1913E</u> S E | | | |
| 11 miles <u>W</u> of <u>Foxworth</u> (distance) (direction) (nearest town) | | | |
| WELL PURPOSE: (home, irrigation, municipal, industrial) | | | |
| WELL COMPLETION DATA: | | | |
| (1) diameter (inches) <u>4</u> | | | |
| (2) total depth (feet) <u>205</u> | | | |
| (3) static water level (feet) <u>90</u> <u>below</u> top of ground. above | | | |
| (4) casing <u>pvc</u> , <u>2195</u> (material) (depth) | | | |
| (size) if telescope see back. | | | |
| (5) screen <u>10</u> , <u>195</u> (length) (depth to top) | | | |
| (size) <u>4</u> , <u>pvc</u> (material) | | | |
| (6) pump <u>1</u> , <u>14</u> (HP) (yield gpm) | | | |
| (type power) <u>elect</u> | | | |
| (7) electric log (yes or no) | | | |
| (organization running log) | | | |
| (8) how well bottom plugged <u>sand</u> <u>SHAR K</u> | Rec'd 9/21/79 | | |
| DRILLERS REMARKS: <u>good well</u> | Dnr. LW | | |

If well telescopes please
sketch and show depths.

GROUND LEVEL

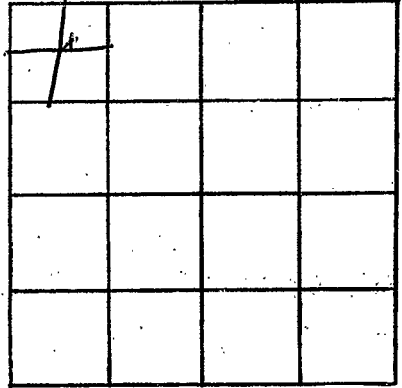

SECTION 2

Please indicate well location X.

ADDITIONAL INFORMATION

Lined area for additional information.

If more than one screen,
show locations of each on sketch.