

MARION
 K 254
 8-2-79
 8-2

MISSISSIPPI
 BOARD OF WATER COMMISSIONERS
 416 North State Street
 Jackson, Mississippi 39201

WATER WELL DRILLERS LOG

Hollinger Well Service Marion

date well completed


firm name

county well located

LANDOWNER: Willie M. Fubis	description of formations encountered	from	to
RT 3	Clay	0	20
Foyworth, Ms. (mailing address)	g. gravel, clay	20	40
WELL LOCATION:	SHARK	40	50
sec. 20 T. 3 (N) S R. 19 E W	sand, pea gravel	50	127
1 1/4 miles W of Foyworth (distance) (direction) (nearest town)			
WELL PURPOSE: (home, irrigation, municipal, industrial)			
WELL COMPLETION DATA:			
(1) diameter (inches) 2"			
(2) total depth (feet) 127			
(3) static water level (feet) 90 below top of ground.			
(4) casing PVC 117 (material) (depth)			
_____ if telescope see back. (size)			
(5) screen 10 117 (length) (depth to top)			
2 PVC (size) (material)			
(6) pump 1 9 (HP) (yield gpm)			
elect (type power)			
(7) electric log _____ (yes or no)			
_____ (organization running log)			
(8) how well bottom plugged sand SHARK	Rec'd 9/21/79		
DRILLERS REMARKS: Good well	Dnr. LW		

If well telescopes please sketch and show depths.

GROUND LEVEL

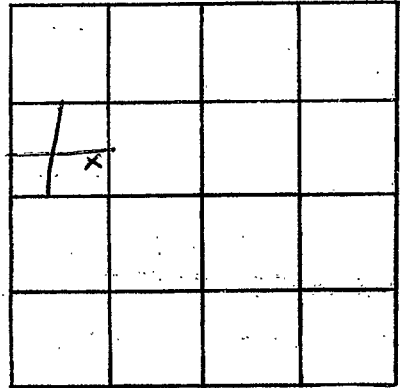

SECTION 20

Please indicate well location X.

ADDITIONAL INFORMATION

If more than one screen, show locations of each on sketch.