

Marion
K 2055
9-13-79

MISSISSIPPI
 BOARD OF WATER COMMISSIONERS
 416 North State Street
 Jackson, Mississippi 39201

WATER WELL DRILLERS LOG

9-13 1979 Hollinger Marion
 date well completed firm name county well located

LANDOWNER: Tommy Howard
Rt 2
Columbia, MS
 (mailing address)

description of formations encountered	from	to
<u>C + AK, gravel</u>	<u>0</u>	<u>30</u>
<u>sand, gravel</u>	<u>30</u>	<u>78</u>

WELL LOCATION:
 sec. 10 T. 3 (N) S. R. 13 (E) W. 3 miles N of Pine Bluff
 (distance) (direction) (nearest town)

WELL PURPOSE:
 (home, irrigation, municipal, industrial)

- WELL COMPLETION DATA:
- (1) diameter (inches) 2
 - (2) total depth (feet) 78
 - (3) static water level (feet) 10 below above top of ground.
 - (4) casing pvc, 73,
 (material) (depth)
 (size) if telescope see back.
 - (5) screen 5, 73
 (length) (depth to top)
2, pvc
 (size) (material)
 - (6) pump 1, 10
 (HP) (yield gpm)
elect
 (type power)
 - (7) electric log _____
 (yes or no)


(organization running log)
 (8) how well bottom plugged 5 And
SHANK

DRILLERS REMARKS: Very Good

Rec'd 9/21/79
Dur-LW

If well telescopes please sketch and show depths.

GROUND LEVEL

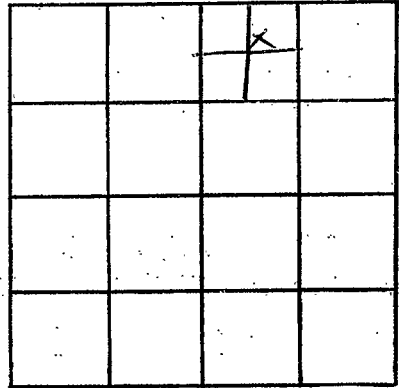

SECTION 10

Please indicate well location X.

ADDITIONAL INFORMATION

Lined area for additional information.

If more than one screen, show locations of each on sketch.