

Marion
R
2056
7-10-79
7/10 1979

MISSISSIPPI
 BOARD OF WATER COMMISSIONERS
 416 North State Street
 Jackson, Mississippi 39201

WATER WELL DRILLERS LOG

29 TOM GRIFFITH
PLUMBING & WELL SERVICE, INC.

date well completed 7/10 1979 firm name Tom Griffith county well located Marion

LANDOWNER: Mr. Charles Harrison
Columbia, Miss.
 (mailing address)
 WELL LOCATION:
 sec. 4 T. 3 (N) R. 19 E 135
4 miles W of Columbia
 (distance) (direction) (nearest town)

description of formations encountered	from	to
<u>Top Soil</u>	<u>0</u>	<u>1</u>
<u>Clay</u>	<u>1</u>	<u>17</u>
<u>Sand</u>	<u>17</u>	<u>29</u>
<u>Gravel</u>	<u>29</u>	<u>36</u>
<u>Clay</u>	<u>36</u>	<u>141</u>
<u>Sand</u>	<u>141</u>	<u>149</u>
<u>Gravel</u>	<u>149</u>	<u>181</u>
<u>Clay</u>	<u>181</u>	<u>200</u>

WELL PURPOSE: Home
 (home, irrigation, municipal, industrial)

- WELL COMPLETION DATA:
- (1) diameter (inches) 2"
 - (2) total depth (feet) 200 ft.
 - (3) static water level (feet) 140 ft. below top of ground.
 - (4) casing plastic 180 ft.
 (material) (depth)
2" if telescope see back.
 (size)
 - (5) screen 20 ft. 180 ft.
 (length) (depth to top)
2" plastic
 (size) (material)
 - (6) pump 1 HP 10 gpm
 (HP) (yield gpm)
Electric
 (type power)
 - (7) electric log No
 (yes or no)

(organization running log)


(8) how well bottom plugged Bank Wash Valve

DRILLERS REMARKS:

Rec'd 9/21/79
D.R. - L.W.

If well telescopes please sketch and show depths.

GROUND LEVEL

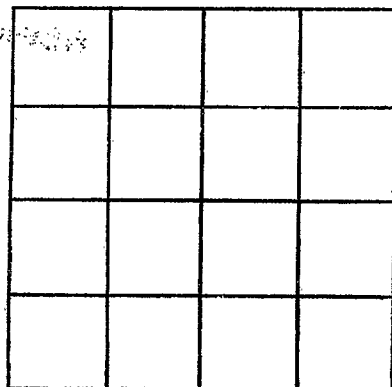

SECTION _____

Please indicate well location X.

ADDITIONAL INFORMATION

If more than one screen, show locations of each on sketch.