

MARION
K 2057
4-20-79

MISSISSIPPI
BOARD OF WATER COMMISSIONERS
416 North State Street
Jackson, Mississippi 39201

WATER WELL DRILLERS LOG

4/20 1979 Hollinsworth MARION
date well completed firm name county well located

LANDOWNER: Silvia Faust
Rt 2
Foxworth, MS
(mailing address)

WELL LOCATION:
2 sec. 29 T 30 N 13 E
S R 19 E
W
7 miles SW of Foxworth
(distance) (direction) (nearest town)

WELL PURPOSE:
(home, irrigation, municipal, industrial)

- WELL COMPLETION DATA:
- (1) diameter (inches) 4"
 - (2) total depth (feet) 420
 - (3) static water level (feet) 280 ^{below} _{above} top of ground.
 - (4) casing PVC, 400
(material) (depth)
(size) if telescope see back.
 - (5) screen 10, 410
(length) (depth to top)
4, PVC
(size) (material)
 - (6) pump 1, 8
(HP) (yield gpm)
elect
(type power)
 - (7) electric log
(yes or no)

description of formations encountered	from	to
Sand, gravel, chalk	0	240
chalk	240	300
Sand, chalk	300	360
sand	360	420

(organization running log)

(8) how well bottom plugged sand
SHARK

DRILLERS REMARKS: good well


Miss. Board of Water Comm.

MAY 14 1979

RECEIVED

If well telescopes please sketch and show depths.

GROUND LEVEL

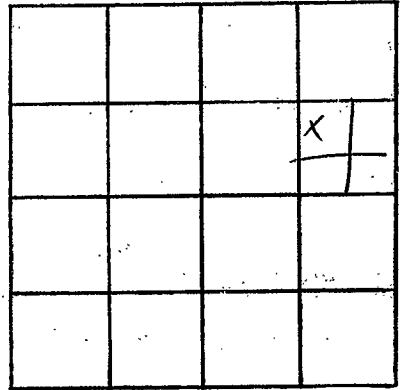

SECTION 29

Please indicate well location X.

ADDITIONAL INFORMATION

If more than one screen, show locations of each on sketch.