

MARION

K 2059

02-28-79

MISSISSIPPI
BOARD OF WATER COMMISSIONERS
416 North State Street
Jackson, Mississippi 39201

WATER WELL DRILLERS LOG

Feb. 28

1999

Tom Guffey

Marion

date well completed

firm name

county well located

Pleasant & Well

LANDOWNER:

Mr. Joe Barber

239 South High School Ave.
Columbia, Mo. (mailing address)

WELL LOCATION:

sec. 29 T 3 N R 13 E
S W5 miles W of Fawnville
(distance) (direction) (nearest town)

WELL PURPOSE:

(home, irrigation, municipal, industrial)

WELL COMPLETION DATA:

- (1) diameter (inches) 2"
- (2) total depth (feet) 250
- (3) static water level (feet) 70 ft below top of ground.
- (4) casing Plastic 230 ft.
(material) (depth)
2" (size) if telescope see back.
- (5) screen 20 ft, 230 ft
(length) (depth to top)
2" plastic
(size) (material)
- (6) pump 2 HP 10
(HP) (yield gpm)
Electric
(type power)
- (7) electric log no
(yes or no)

(organization running log)

- (8) how well bottom plugged

Back Wash Valve

DRILLERS REMARKS:

description of formations encountered

from

to

Topsoil	0	1
Clay	1	19
Gravel	19	49
Sand	49	86
Chalk	86	122
Shale	122	178
Hard	178	250


Miss. Board of Water Comm.

MAY - 4 1979

RECEIVED

If well telescopes please
sketch and show depths.

GROUND LEVEL

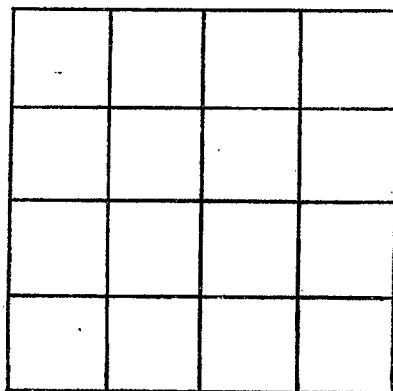

SECTION _____

Please indicate well location X.

ADDITIONAL INFORMATION

If more than one screen,
show locations of each on sketch.