

MARTON
K 2060
2-19-79

MISSISSIPPI
BOARD OF WATER COMMISSIONERS
416 North State Street
Jackson, Mississippi 39201

WATER WELL DRILLERS LOG

Feb. 19 1979 TOM GRIFFITH
date well completed PLUMBING & WELL SERVICE, INC. county well located

320 MAYSON AVE.
COLUMBIA MISSISSIPPI

LANDOWNER:

Mrs. Ova Pearl Rogers
Rt. 2 - Columbia Miss.
(mailing address)

Section of formations encountered	from	to
Shale	0	2
Clay	2	15
Gravel	15	39
Chalk	39	81
Sand	81	130

WELL LOCATION:

sec. 20 T. 3 N. R. 12 E. 7/30
5 miles SW of Columbia
(distance) (direction) (nearest town)

WELL PURPOSE:

Home
(home, irrigation, municipal, industrial)

WELL COMPLETION DATA:

- (1) diameter (inches) 2"
- (2) total depth (feet) 130 ft.
- (3) static water level (feet) 80 ft. below top of ground.
- (4) casing plastic, 110 ft. (material) (depth)
2" (size) if telescope see back.
- (5) screen 20 ft., 110 ft. (length) (depth to top)
2" plastic (size) (material)
- (6) pump 1 1/2 HP, 7 (HP) (yield gpm)
Electric (type power)
- (7) electric log No (yes or no)

(organization running log)

(8) how well bottom plugged

Back Wash Valve

DRILLERS REMARKS:


Miss. Board of Water Comm.

FEB 23 1979

RECEIVED

If well telescopes please sketch and show depths.

GROUND LEVEL

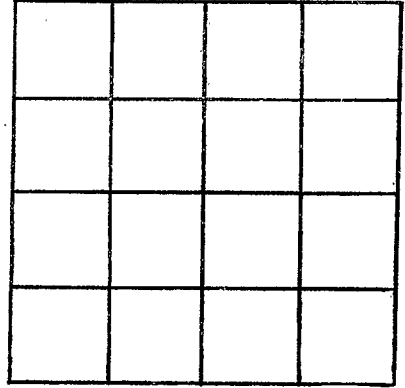

SECTION _____

Please indicate well location X.

ADDITIONAL INFORMATION

If more than one screen,
show locations of each on sketch.