

MARION  
 K 2061  
 1-29-80  
 1-29-80

MISSISSIPPI  
 BOARD OF WATER COMMISSIONERS  
 416 North State Street  
 Jackson, Mississippi 39201

WATER WELL DRILLERS LOG  
 TOM GRIFFITH  
 PLUMBING & WELL SERVICE, INC.  
 320 MAYSON AVE.  
 COLUMBIA, MS 39429

Marion  
 county well located

LANDOWNER:

Opal Cox  
 Rt. 1 Box 380 Foxworth, Ms.  
 (mailing address)

description of fomations encountered

TOPSOIL  
 SAND  
 CHALK  
 SAND

from	to
0	1
1	30
30	40
40	65

WELL LOCATION:

sec. 15 T. 3 N R. 14 E  
 S 13E  
 1/2 mile West of Foxworth  
 (distance) (direction) (nearest town)

WELL PURPOSE:

(home, irrigation, municipal, industrial)

WELL COMPLETION DATA:

- (1) diameter (inches) 2"
- (2) total depth (feet) 65'
- (3) static water level (feet) 45' below top of ground.
- (4) casing plastic, 65' (material) (depth)  
 2" (size) if telescope see back.
- (5) screen 10' 55' (length) (depth to top)  
 2" plastic (size) (material)
- (6) pump 1 10 (HP) (yield gpm)  
 Elect. (type power)
- (7) electric log No (yes or no)  
 None (organization running log)
- (8) how well bottom plugged B.W.V.

DEPT. OF NATURAL RESOURCES  
 BUREAU OF LAND & WATER RESOURCES


MAR 10 1980

RECEIVED

DRILLERS REMARKS:

If well telescopes please sketch and show depths.

GROUND LEVEL

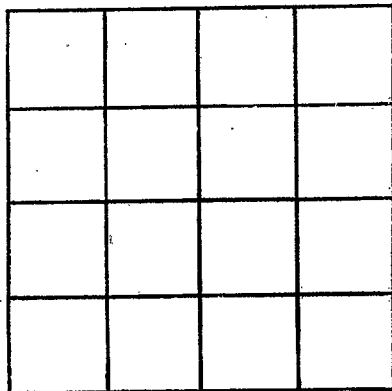

SECTION \_\_\_\_\_

Please indicate well location X.

ADDITIONAL INFORMATION

If more than one screen, show locations of each on sketch.