

MAZIDAN

MISSISSIPPI  
BOARD OF WATER COMMISSIONERS  
416 North State Street  
Jackson, Mississippi 39201

WATER WELL DRILLERS LOG

K 2062  
4-11-80  
4-11

1980 Hollinger  
date well completed firm name  
Madison  
county well located

LANDOWNER: Walter Hollinger  
Rt 2  
Foxworth, MS  
(mailing address)

description of formations encountered	from	to
clay/c gravel	0	25
sand, pebbles	25	40

WELL LOCATION:  
sec. 36 T 20 N R 18 E  
S  
2 1/2 miles S of James town  
(distance) (direction) (nearest town)

WELL PURPOSE: Home  
(home, irrigation, municipal, industrial)

WELL COMPLETION DATA:

- (1) diameter (inches) 2
- (2) total depth (feet) 40
- (3) static water level (feet) 10 below above top of ground.
- (4) casing pvc (material) (depth) (size) If telescope see back.
- (5) screen 5 35 (length) (depth to top) 2 pvc (size) (material)
- (6) pump 1 7 (HP) (yield gpm) elect (type power)
- (7) electric log (yes or no)

(organization running log)

(8) how well bottom plugged sand SPACK

DRILLERS REMARKS: Good well


DEPT. OF NATURAL RESOURCES  
BUREAU OF LAND & WATER RESOURCES

JUL 21 1980

RECEIVED

If well telescopes please sketch and show depths.

GROUND LEVEL

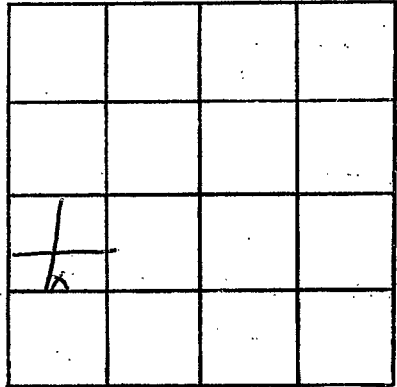

SECTION 36

Please indicate well location X.

ADDITIONAL INFORMATION

If more than one screen, show locations of each on sketch.