

MARION
K 2063
3-25-80

MISSISSIPPI
BOARD OF WATER COMMISSIONERS
416 North State Street
Jackson, Mississippi 39201

WATER WELL DRILLERS LOG

3-25 date well completed 1980 Hollinsire firm name Marion county well located

LANDOWNER: Jerome Smith
RT 3
Foxworth
(mailing address)

description of formations encountered	from	to
<u>sand, clay</u>	<u>0</u>	<u>40</u>
<u>clay</u>	<u>40</u>	<u>60</u>
<u>pea gravel</u>	<u>60</u>	<u>76</u>

WELL LOCATION:
sec. 21 T. 30 N. R. 19 E. S. 35
1 miles W of Foxworth
(distance) (direction) (nearest town)

WELL PURPOSE:
(home, irrigation, municipal, industrial)

- WELL COMPLETION DATA:
- (1) diameter (inches) 2
 - (2) total depth (feet) 76
 - (3) static water level (feet) 50 below above top of ground.
 - (4) casing pvc, 71,
(material) (depth)
(size) if telescope see back.
 - (5) screen 5, 71
(length) (depth to top)
2, pvc
(size) (material)
 - (6) pump 1, 12
(HP) (yield gpm)
elect
(type power)
 - (7) electric log _____
(yes or no)


(organization running log)
 - (8) how well bottom plugged sand
SHANK

DRILLERS REMARKS: good well

DEPT. OF NATURAL RESOURCES
BUREAU OF LAND & WATER RESOURCES
APR 14 1980
RECEIVED

If well telescopes please sketch and show depths.

GROUND LEVEL

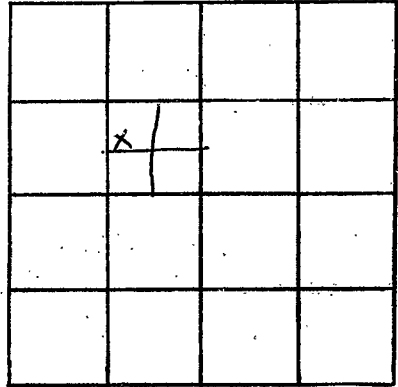

SECTION 21

Please indicate well location X.

ADDITIONAL INFORMATION

If more than one screen, show locations of each on sketch.