

MARION  
K 2064  
3-28-80

MISSISSIPPI  
 BOARD OF WATER COMMISSIONERS  
 416 North State Street  
 Jackson, Mississippi 39201

WATER WELL DRILLERS LOG

3-28 1980 Hollinger Marion  
 date well completed firm name county well located

LANDOWNER: Jerry Cump  
RT1 Box 258  
Foxworth GMS  
 (mailing address)

description of formations encountered	from	to
Red clay gravel	0	60
sand gravel	60	100
pea gravel	100	127

WELL LOCATION:  
 sec. 6 T. 3 N. R. 19 E  
6 miles W of Foxworth  
 (distance) (direction) (nearest town)

WELL PURPOSE:  
 (home, irrigation, municipal, industrial)

- WELL COMPLETION DATA:
- (1) diameter (inches) 2
  - (2) total depth (feet) 127
  - (3) static water level (feet) 70 below above top of ground.
  - (4) casing pvc 127  
 (material) (depth)  
 (size) if telescope see back.
  - (5) screen 5 127  
 (length) (depth to top)  
2 pvc  
 (size) (material)
  - (6) pump 1 elect  
 (HP) (yield gpm)  
elect  
 (type power)
  - (7) electric log                       
 (yes or no)  
 (organization running log)
  - (8) how well bottom plugged sand  
SHARK


DRILLERS REMARKS: Good well

DEPT. OF NATURAL RESOURCES  
 BUREAU OF LAND & WATER RESOURCES

APR 14 1980  
 RECEIVED

If well telescopes please sketch and show depths.

GROUND LEVEL

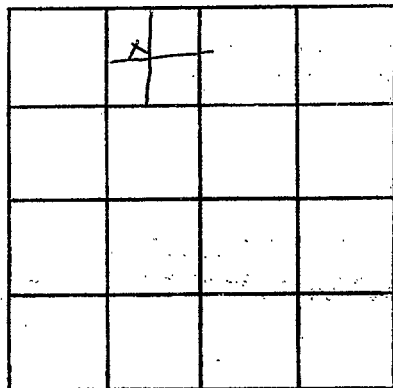

SECTION 6

Please indicate well location X.

ADDITIONAL INFORMATION

If more than one screen, show locations of each on sketch.