

MARION  
R 2065

MISSISSIPPI  
BOARD OF WATER COMMISSIONERS  
416 North State Street  
Jackson, Mississippi 39201

3/12/80  
Thurs. 12 19 80

WATER WELL DRILLERS LOG

TOM GRIFFITH

MARION

date well completed

PLUMBING & WELL SERVICE, INC.  
320 MAYSON AVE

county well located

LANDOWNER: Mr. L. C. SMITH

description of formations encountered

from

to

Rt. 1 Box 339  
Foxworth, Miss  
(mailing address)

Top Soil

0

1

CLAY

1

35

SAND

35

60

CHALK

60

140

SAND & GRAVEL

140

225

WELL LOCATION:

sec. 30 T. 3 N. R. 19 E. 13E

9 miles west of Foxworth  
(distance) (direction) (nearest town)

WELL PURPOSE:

(home, irrigation, municipal, industrial)

WELL COMPLETION DATA:

- (1) diameter (inches) 2"
- (2) total depth (feet) 225'
- (3) static water level (feet) 50 below top of ground.
- (4) casing 2" (material) plastic (depth)
- (5) screen 20 (length) 205 (depth to top)
- (6) pump 1/2 (HP) 8 (yield gpm)
- (7) electric log NO (yes or no)

(organization running log)

(8) how well bottom plugged back wash  
VALVE

DRILLERS REMARKS:


DEPT. OF NATURAL RESOURCES  
BUREAU OF LAND & WATER RESOURCES

MAR 10 1980

RECEIVED

If well telescopes please sketch and show depths.

GROUND LEVEL

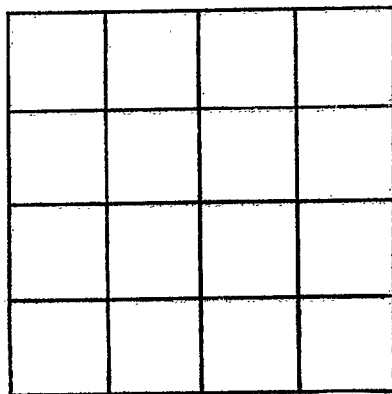

SECTION \_\_\_\_\_

Please indicate well location X.

ADDITIONAL INFORMATION

If more than one screen, show locations of each on sketch.