

MARION  
K 2066  
2-7-80

MISSISSIPPI  
BOARD OF WATER COMMISSIONERS  
416 North State Street  
Jackson, Mississippi 39201

WATER WELL DRILLERS LOG

Feb. 7 1980 TOM GRIFFITH Marion County  
date well completed PLUMBING & WELL SERVICE, INC. county well located  
320 MAYSON AVE.

LANDOWNER: <u>Lillie P Andrews</u>	COL <u>MBIA, MS 39429</u>	description of formations encountered	from	to
<u>Hwy 98 West</u>		<u>Top Soil</u>	<u>0</u>	<u>1'</u>
<u>Joxworth Miss. 39483</u> (mailing address)		<u>SAND &amp; GRAVEL</u>	<u>1'</u>	<u>140"</u>
<b>WELL LOCATION:</b>				
<u>sec 8 T. 3 S R. 11 E</u>				
<u>2</u> miles <u>West</u> of <u>Joxworth</u>				
(distance) (direction) (nearest town)				
<b>WELL PURPOSE:</b> <u>home</u> (home irrigation, municipal, industrial)				
<b>WELL COMPLETION DATA:</b>				
(1) diameter (inches) <u>2"</u>				
(2) total depth (feet) <u>140'</u>				
(3) static water level (feet) <u>85</u> <u>below</u> top of ground				
(4) casing <u>plastic</u> (material) <u>140'</u> (depth)				
(size) If telescope see back.				
(5) screen <u>10'</u> (length) <u>130</u> (depth to top)				
<u>2"</u> (size) <u>plastic</u> (material)				
(6) pump <u>1</u> (HP) <u>8</u> (yield gpm)				
(type power)				
(7) electric log <u>electric</u> (yes or no)				
(organization running log)				
(8) how well bottom plugged				
DRILLERS REMARKS:				


DEPT. OF NATURAL RESOURCES  
BUREAU OF LAND & WATER RESOURCES

MAR 10 1980

RECEIVED

If well telescopes please sketch and show depths.

GROUND LEVEL

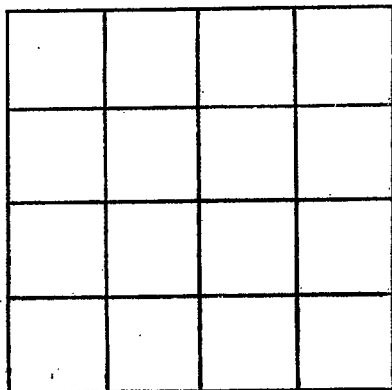

SECTION \_\_\_\_\_

Please indicate well location X.

ADDITIONAL INFORMATION

If more than one screen, show locations of each on sketch.