

MARION
K 2067

MISSISSIPPI
BOARD OF WATER COMMISSIONERS
416 North State Street
Jackson, Mississippi 39201

2-4-80
2-4-80

WATER WELL DRILLERS LOG

TOM BRIFFITH

Marion

date well completed

firm name

county well located

LANDOWNER:	description of fomations encountered.	from	to
H. B. Rowell			
Rt. 1 Foxworth, Ms. (mailing address)	Sand & Gravel	1	180
WELL LOCATION:			
sec 7 T 3 N R 19 E 8 miles East of Foxworth (distance) (direction) (nearest town)			
WELL PURPOSE: (home, irrigation, municipal, industrial)			
WELL COMPLETION DATA:			
(1) diameter (inches) 4"			
(2) total depth (feet) 180'			
(3) static water level (feet) 75' below top of ground.			
(4) casing plastic, 180' (material) (depth)			
4" If telescope see back. (size)			
(5) screen 20' 160' (length) (depth to top)			
4" plastic (size) (material)			
(6) pump 1 12 (HP) (yield gpm)			
Elect. (type power)			
(7) electric log No (yes or no)			
None (organization running log)			
(8) how well bottom plugged B.W.U.			
DRILLERS REMARKS:			


DEPT. OF NATURAL RESOURCES
BUREAU OF LAND & WATER RESOURCES

MAR 10 1980

RECEIVED

If well telescopes please sketch and show depths.

GROUND LEVEL

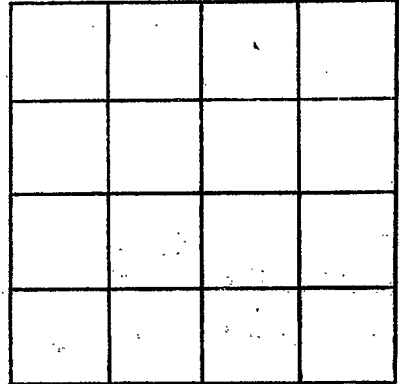

SECTION _____

Please indicate well location X.

ADDITIONAL INFORMATION

Lined area for providing additional information, consisting of 17 horizontal lines.

If more than one screen, show locations of each on sketch.