

MISSISSIPPI DEPARTMENT OF NATURAL RESOURCES

Bureau of Land and Water Resources

Southport Mall


P.O. Box 10631

Jackson, Mississippi 39209

WATER WELL DRILLERS LOG

(Cleveland McCraw)

DUNAWAYS PLUMBING

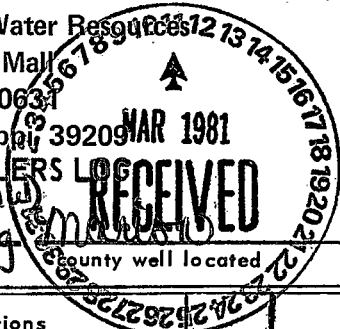

MARION
K 2069
2/2/81
2/2 1981

date well completed

firm name

county well located

LANDOWNER: Henry Dale Roberts

Description of formations encountered

from to

Route 1 Box 211
Kokomo, Ms. 39643
(mailing address)

top
clay
sand
chalk
sand

0 6ft
6 4ft
48 51ft
51 90ft
90 104ft

WELL LOCATION:

sec. 18 T-3 N R-18 E
S E
0.1 miles E of Nama
(distance) (direction) (nearest town)

WELL PURPOSE:

(home) Irrigation, municipal, industrial

WELL COMPLETION DATA:

- (1) diameter (inches) 4 inch
- (2) total depth (feet) 104 ft.
- (3) static water level (feet) 28 below top of ground.
- (4) casing PVC 104 ft. (material) (depth)
- (size) if telescope see back.
- (5) screen 10 ft. 9 ft. (length) (depth to top)
- Hardy PVC (size) (material)
- (6) pump none set on (HP) (yield gpm)
- (type power)
- (7) electric log No (yes or no)
- (organization running log)

(8) how well bottom plugged sand
shank

DRILLERS REMARKS:

DEPT. OF NATURAL RESOURCES
BUREAU OF LAND & WATER RESOURCES

MAR 11 1981

RECEIVED

If well telescopes please sketch and show depths.

GROUND LEVEL

SECTION _____

Please indicate well location X.

ADDITIONAL INFORMATION

If more than one screen, show locations of each on sketch.