

Marion
 # K 2090
 8-27-81

MISSISSIPPI
 BOARD OF WATER COMMISSIONERS
 416 North State Street
 Jackson, Mississippi 39201

WATER WELL DRILLERS LOG

aug 27 1981 Reynolds See Marion
 date well completed firm name county well located

LANDOWNER:
Garry Smith
Rt 3 Faywardh
 (mailing address)

description of formations encountered	from	to
<u>red sandy clay</u>	<u>0</u>	<u>28</u>
<u>red sand</u>	<u>28</u>	<u>90</u>
<u>Sand + gravel</u>	<u>90</u>	<u>105</u>
<u>Red sand</u>	<u>105</u>	<u>160</u>
<u>med Chalk & sand</u>	<u>160</u>	<u>200</u>
<u>Coarse sand</u>	<u>200</u>	<u>221</u>

WELL LOCATION:
 sec. 31 T. 3 N R. 13 E
 (distance) miles (direction) of (nearest town)

WELL PURPOSE: home
 (home, irrigation, municipal, industrial)

WELL COMPLETION DATA:

(1) diameter (inches) 4"

(2) total depth (feet) 221

(3) static water level (feet) 160 ^{above} below top of ground.

(4) casing plastic bottom
 (material) (depth)
 (size) if telescope see back.

(5) screen 10' 201'
 (length) (depth to top)
4" plastic
 (size) (material)

(6) pump 1 1/2 15
 (HP) (yield gpm)
elect
 (type power)

(7) electric log no
 (yes or no)
 (organization running log)

DEPT. OF NATURAL RESOURCES
 BUREAU OF LAND & WATER RESOURCES

MAY 14 1981


(8) how well bottom plugged
wooden plug

DRILLERS REMARKS:
old 2" plastic
will not Bad.

RECEIVED

If well telescopes please sketch and show depths.

GROUND LEVEL

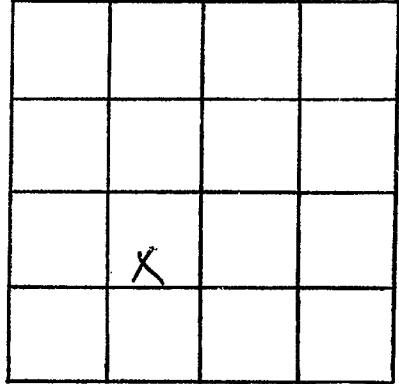

SECTION 31

Please indicate well location X.

ADDITIONAL INFORMATION

Lined area for additional information.

If more than one screen, show locations of each on sketch.