

Marion
K 2022
7-17-81

MISSISSIPPI
BOARD OF WATER COMMISSIONERS
416 North State Street
Jackson, Mississippi 39201
WATER WELL DRILLERS LOG

7-17 1981 Holliston Marion
date well completed firm name county well located

LANDOWNER: Spoke Jffum
R+1
Kokona Ms.
(mailing address)

description of formations encountered	from	to
sand, gravel	0	140
clay	140	180
sand, gravel	180	200

WELL LOCATION:
sec. 18 T. 3 N R. 20 E
4 miles W of Foxworth
(distance) (direction) (nearest town)

WELL PURPOSE:
(home, irrigation, municipal, industrial)


- WELL COMPLETION DATA:
- (1) diameter (inches) 2
 - (2) total depth (feet) 200
 - (3) static water level (feet) 160 below top of ground.
 - (4) casing PVC 195 (material) (depth)
 - (size) If telescope see back.
 - (5) screen 5 195 (length) (depth to top)
 - (size) 2 (material) PVC
 - (6) pump 2 4 (HP) (yield gpm)
 - (type power) elect
 - (7) electric log (yes or no)
 - (organization running log)
 - (8) how well bottom plugged sand shale

DRILLERS REMARKS: good well

DEPT. OF NATURAL RESOURCES
BUREAU OF LAND & WATER RESOURCES


AUG 26 1981

RECEIVED

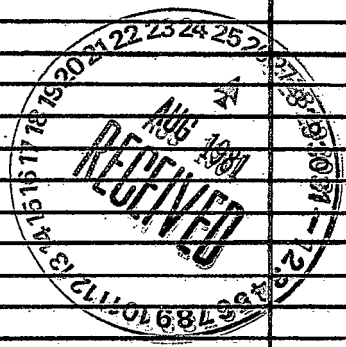

If well telescopes please
sketch and show depths.

GROUND LEVEL

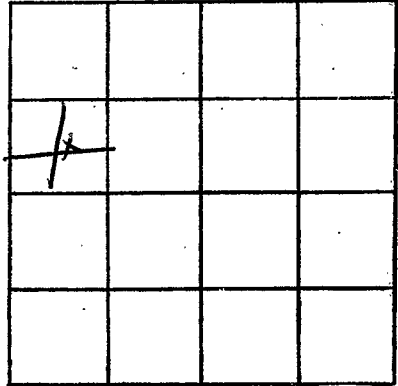

SECTION 18

Please indicate well location X.

ADDITIONAL INFORMATION

If more than one screen,
show locations of each on sketch.