

MISSISSIPPI DEPARTMENT OF NATURAL RESOURCES

Bureau of Land and Water Resources

Southport Mall

P.O. Box 10631

Jackson, Mississippi 39209

WATER WELL DRILLERS LOG

Marion
K2573

9-10-81 Dollinger Marion
date well completed firm name county well located

LANDOWNER: <u>Katherine Bristle</u>	description of formations encountered	from	to
<u>Rt. 1</u>	<u>sand, gravel</u>	<u>0</u>	<u>100</u>
<u>Foxworth, m.s.</u> (mailing address)	<u>Chalk</u>	<u>100</u>	<u>140</u>
<u>sand, gravel</u>	<u></u>	<u>140</u>	<u>190</u>
WELL LOCATION:			
sec. <u>18</u> T. <u>30</u> N. R. <u>13</u> E. S W			
<u>4</u> miles <u>W</u> of <u>Foxworth</u> (distance) (direction) (nearest town)			
WELL PURPOSE:			
<u>(home)</u> Irrigation, municipal, industrial			
WELL COMPLETION DATA:			
(1) diameter (inches) <u>2</u>			
(2) total depth (feet) <u>190</u>			
(3) static water level (feet) <u>100</u> <u>below</u> above top of ground.			
(4) casing <u>PVC</u> , <u>190</u> (material) (depth)			
<u></u> If telescope see back. (size)			
(5) screen <u>10</u> , <u>180</u> (length) (depth to top)			
<u>2</u> , <u>PVC</u> (size) (material)			
(6) pump <u></u> (HP) <u></u> (yield gpm)			
<u></u> (type power)			
(7) electric log <u></u> (yes or no)			
<u></u> (organization running log)			
(8) how well bottom plugged <u></u>			
DRILLERS REMARKS: <u>very good</u>			


copy

DEPT. OF NATURAL RESOURCES
BUREAU OF LAND & WATER RESOURCES

NOV 17 1982
RECEIVED

If well telescopes please sketch and show depths.

GROUND LEVEL

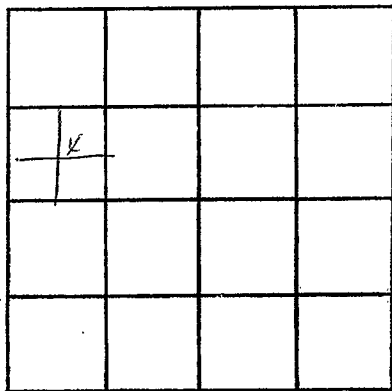

SECTION 18

Please indicate well location X.

ADDITIONAL INFORMATION

If more than one screen,
show locations of each on sketch.