

**MISSISSIPPI
BOARD OF WATER COMMISSIONERS**
416 North State Street
Jackson, Mississippi 39201

WATER WELL DRILLERS LOG

Mallory
K 2074

2-17-1982 date well completed TOM GRIFFITH firm name Mallory county well located MISSISSIPPI
800 BRAYSON AVE

LANDOWNER: Antock Baptist Church
101, Forsyth, MS
(mailing address)

description of formations encountered	from	to
<u>hard red ground</u>	<u>0</u>	<u>25</u>
<u>chalk</u>	<u>25</u>	<u>35</u>
<u>gravel</u>	<u>35</u>	<u>100</u>

WELL LOCATION:
sec. 17 T 3 N R 19 E
S W
3 miles South of Forsyth
(distance) (direction) (nearest town)

WELL PURPOSE: Church
(home, irrigation, municipal, industrial)

- WELL COMPLETION DATA:
- diameter (inches) 2"
 - total depth (feet) 100
 - static water level (feet) 18 below above top of ground.
 - casing PVC, 90,
(material) (depth)
2 if telescope see back.
(size)
 - screen 2, 80
(length) (depth to top)
2, PVC
(size) (material)
 - pump 1/2, 10
(HP) (yield gpm)
Elect
(type power)
 - electric log no
(yes or no)
n/a
(organization running log)
 - how well bottom plugged BWB

DRILLERS REMARKS:


DEPT. OF NATURAL RESOURCES
BUREAU OF LAND & WATER RESOURCES

JUN - 9 1982

RECEIVED

If well telescopes please sketch and show depths.

GROUND LEVEL

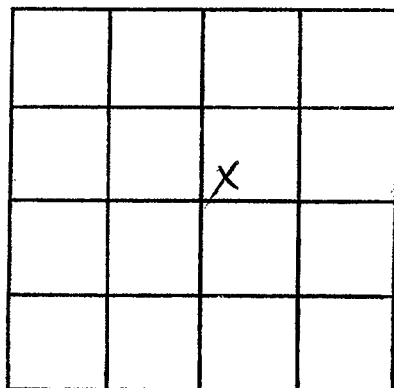

SECTION 17

Please indicate well location X.

ADDITIONAL INFORMATION

If more than one screen,
show locations of each on sketch.