

MISSISSIPPI DEPARTMENT OF NATURAL RESOURCES

Bureau of Land and Water Resources

Southport Mall

P.O. Box 10631

Jackson, Mississippi 39209

WATER WELL DRILLERS LOG

Marion
K
2075

5-27 1982 Hallgren Marion
date well completed firm name county well located

LANDOWNER: <u>Charles Odum</u>	description of formations encountered	from	to
<u>RT1</u>			
<u>Foxworth, Ms.</u> (mailing address)	<u>SAND gravel</u> <u>clastic</u> <u>per gravel, sand</u>	<u>0</u> <u>80</u> <u>90</u>	<u>80</u> <u>90</u> <u>105</u>
WELL LOCATION:			
sec. <u>18</u> T- <u>3</u> N R- <u>13</u> E			
<u>3</u> miles <u>W</u> of <u>Foxworth</u> (distance) (direction) (nearest town)			
WELL PURPOSE:			
<u>(home)</u> , irrigation, municipal, industrial			
WELL COMPLETION DATA:			
(1) diameter (inches) <u>2</u>			
(2) total depth (feet) <u>105</u>			
(3) static water level (feet) <u>80</u> <u>below</u> <u>above</u> top of ground.			
(4) casing <u>pvc</u> <u>100</u> (material) (depth)			
<u> </u> if telescope see back. (size)			
(5) screen <u>5</u> <u>100</u> (length) (depth to top)			
<u>2</u> <u>pvc</u> (size) (material)			
(6) pump <u>1</u> <u>8</u> (HP) (yield gpm)			
<u>elect</u> (type power)			
(7) electric log <u> </u> (yes or no)			
<u> </u> (organization running log)			
(8) how well bottom plugged <u>SAND</u> <u>SHANK</u>			
DRILLERS REMARKS: <u>Good well</u>			

COPY


DEPT. OF NATURAL RESOURCES
BUREAU OF LAND & WATER RESOURCES

NOV 16 1982

RECEIVED

If well telescopes please sketch and show depths.

GROUND LEVEL

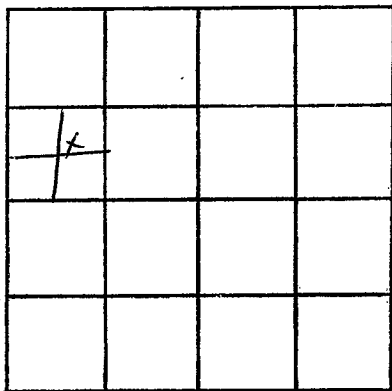

SECTION 18

Please indicate well location X.

ADDITIONAL INFORMATION

If more than one screen,
show locations of each on sketch.