

MISSISSIPPI DEPARTMENT OF NATURAL RESOURCES

Bureau of Land and Water Resources

Southport Mall

P.O. Box 10631

Jackson, Mississippi 39209

WATER WELL DRILLERS LOG

Marion
K K
2076

10-3 1983 Hollinger Marion
 date well completed firm name county well located

LANDOWNER: Josh Demaray
Rt 1
Foxworth, MS
 (mailing address)

description of formations encountered	from	to
Chalk	0	180
Sand, gravel	100	360
Chalk	360	400
Sand	400	460

WELL LOCATION:
 sec. 10-T-30N R-19E
1 miles W of Foxworth
 (distance) (direction) (nearest town)

WELL PURPOSE:
 (home, irrigation, municipal, industrial)

WELL COMPLETION DATA:

(1) diameter (inches) 3

(2) total depth (feet) 460

(3) static water level (feet) 125 ^{ft} below above top of ground.

(4) casing PVC 440
 (material) (depth)

3 if telescope see back.
 (size)

(5) screen 20 440
 (length) (depth to top)

3 PVC
 (size) (material)

(6) pump ND 75
 (HP) (yield gpm)

Flow
 (type power)

(7) electric log (yes or no) _____

_____ (organization running log)

(8) how well bottom plugged sand
5 MARK

DRILLERS REMARKS: Very good well


DEPT. OF NATURAL RESOURCES
 BUREAU OF LAND & WATER RESOURCES

OCT 20 1983

RECEIVED

If well telescopes please sketch and show depths.

GROUND LEVEL

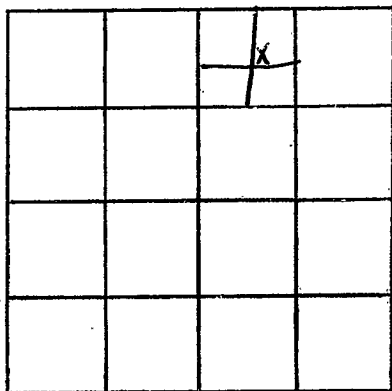

SECTION 10

Please indicate well location X.

ADDITIONAL INFORMATION

If more than one screen,
show locations of each on sketch.