

MISSISSIPPI DEPARTMENT OF NATURAL RESOURCES

Bureau of Land and Water Resources

Southport Mall

P.O. Box 10631

Jackson, Mississippi 39209

WATER WELL DRILLERS LOG

MARION
K 2077

5-18 1984
date well completed

Hollinger
firm name

Monroe
county well located

LANDOWNER: S. Graham
RT 1
Foxworth
(mailing address)

description of formations encountered	from	to
SAND, clay gravel	100	100
SAND, chert	100	150
cherty, pebbles	150	300
fine gravel, fine sand	300	452

WELL LOCATION:
sec. 9 T. 30 N. R. 12 E. 35 W.
2 miles SW of Foxworth
(distance) (direction) (nearest town)

WELL PURPOSE: pond
(home, irrigation, municipal, industrial)

WELL COMPLETION DATA:

- (1) diameter (inches) 3"
- (2) total depth (feet) 472
- (3) static water level (feet) 1 below top of ground.
- (4) casing PVC 442 (material) (depth)
(size) if telescope see back.
- (5) screen 30 442 (length) (depth to top)
3 PVC (size) (material)
- (6) pump NONE 30 (HP) (yield gpm)
ARTESIAN (type power)
- (7) electric log (yes or no)
(organization running log)
- (8) how well bottom plugged SAND SPARK

DRILLERS REMARKS: Flow well very good


DEPT. OF NATURAL RESOURCES
BUREAU OF LAND & WATER RESOURCES

JUL 31 1984

RECEIVED

If well telescopes please sketch and show depths.

GROUND LEVEL

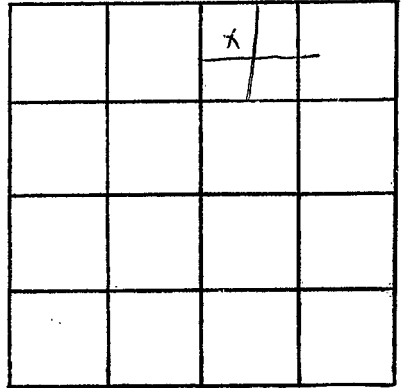

SECTION 9

Please indicate well location X.

ADDITIONAL INFORMATION

If more than one screen,
show locations of each on sketch.